


Sections 7, 8 & 9, T6S, R20E, W.M.
Wheeler County

CLAIM OF BENEFICIAL USE MAP
Transfer T-11670
Stanley Ranch LLC

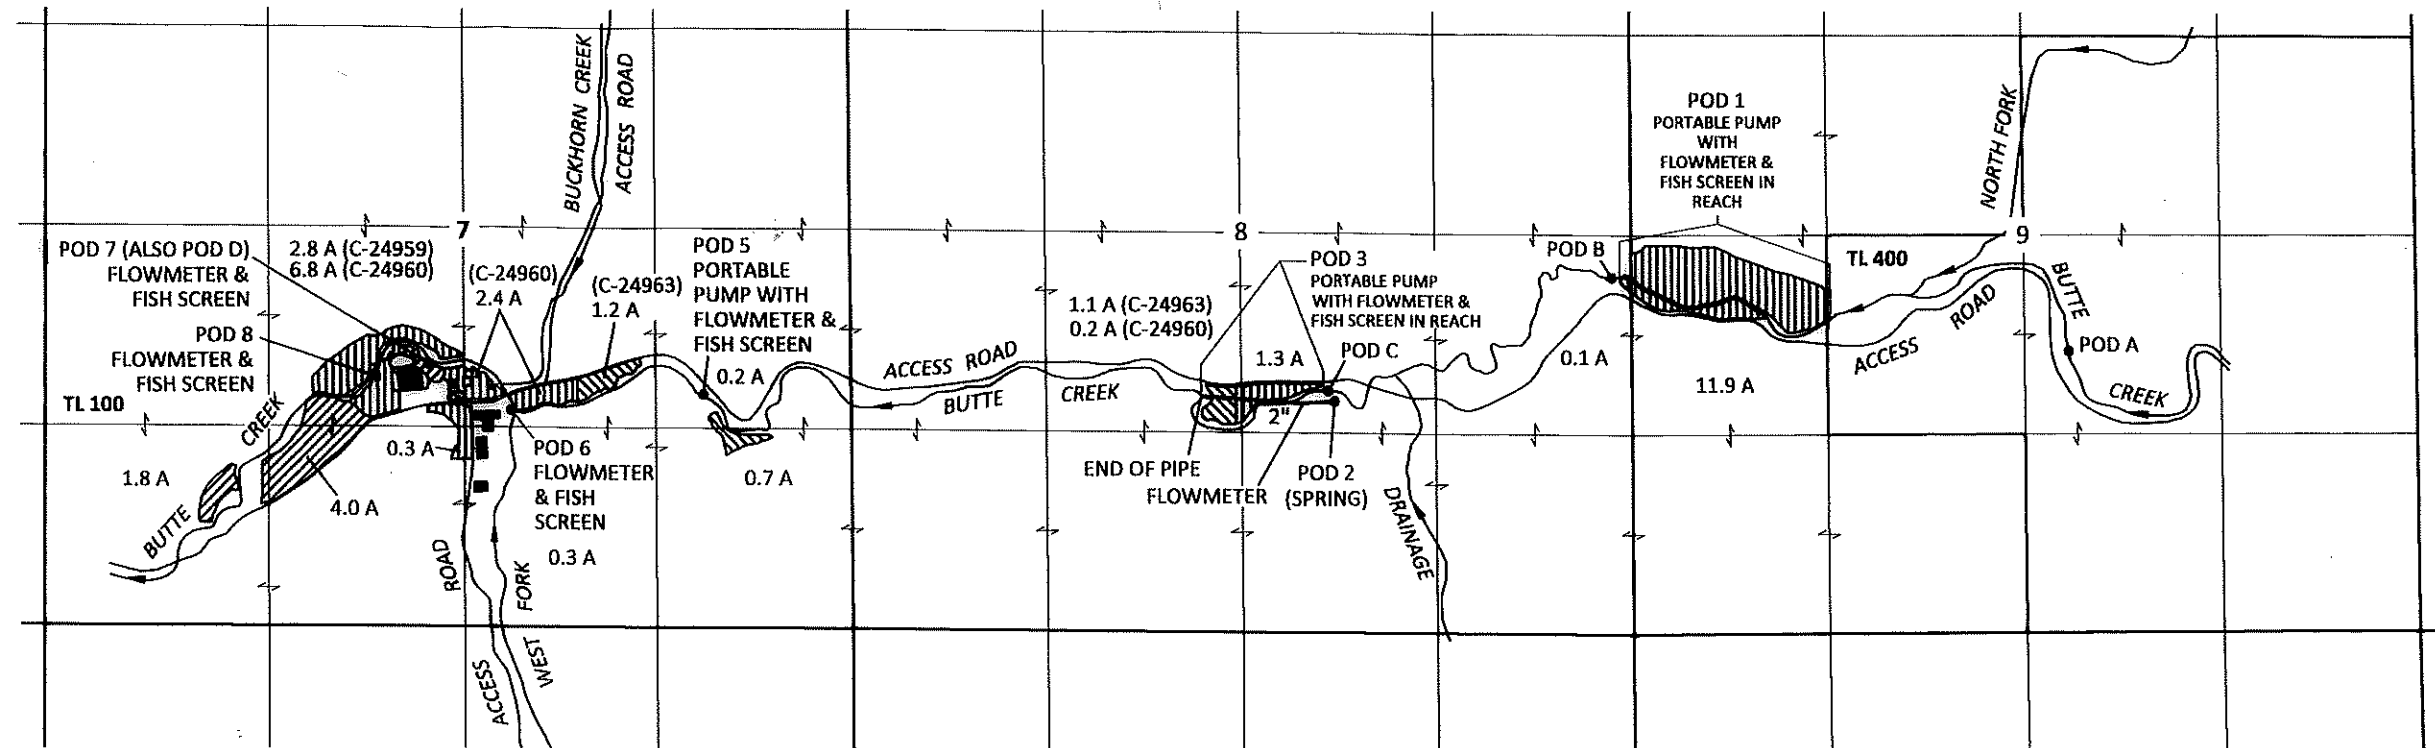


POD 1 LOCATION: 2150 FT N AND 1350 FT E EXTENDING TO 2440 FT N AND 100 FT W FROM SE CORNER SECTION 8, T6S, R20E, W.M.
POD 2 LOCATION: 1590 FT N AND 2060 FT W FROM SE CORNER SECTION 8, T6S, R20E, W.M.
POD 3 LOCATION: 1660 FT N AND 2130 FT W EXTENDING TO 1630 FT N AND 2970 FT W FROM SE CORNER SECTION 8, T6S, R20E, W.M.
POD 5 LOCATION: 1590 FT N AND 1020 FT W FROM SE CORNER SECTION 7, T6S, R20E, W.M.
POD 6 LOCATION: 1490 FT N AND 2350 FT W FROM SE CORNER SECTION 7, T6S, R20E, W.M.
POD 7 LOCATION: 1780 FT N AND 2650 FT E FROM SW CORNER SECTION 7, T6S, R20E, W.M.
POD 8 LOCATION: 1690 FT N AND 2290 FT E FROM SW CORNER SECTION 7, T6S, R20E, W.M.
POD A LOCATION: 1940 FT N AND 2980 FT E FROM SW CORNER SECTION 9, T6S, R20E, W.M.
POD B LOCATION: 2430 FT N AND 150 FT W FROM SE CORNER SECTION 8, T6S, R20E, W.M.
POD C LOCATION: 1660 FT N AND 2100 FT W FROM SE CORNER SECTION 8, T6S, R20E, W.M.
POD D LOCATION: 1780 FT N AND 2650 FT E FROM SW CORNER SECTION 7, T6S, R20E, W.M.

EXPLANATION

-  PLACE OF USE - CERTIFICATE 24959 IRRIGATION - 8.6 ACRES PRIORITY DATE: 1880
-  PLACE OF USE - CERTIFICATE 24960 IRRIGATION - 23.3 ACRES PRIORITY DATE: 1886
-  PLACE OF USE - CERTIFICATE 24963 IRRIGATION - 3.2 ACRES PRIORITY DATE: 1895
-  POINT OF DIVERSION (POD)
-  BURIED PIPE (APPROX.)


Site Inspections Conducted:
June 6, 2018,
August 9, 2020 &
April 21, 2021

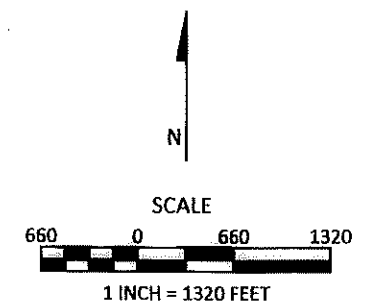

May 13, 2021

This map is not intended to provide legal dimensions or locations of property ownership lines

Figure 1

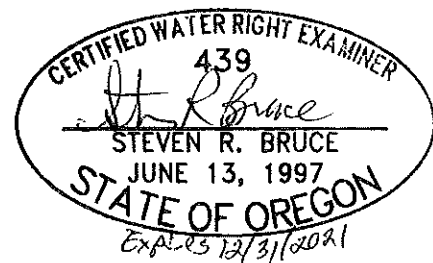

SKOOKUM
WATER ASSOCIATES INC

1626 VICTORIAN WAY
EUGENE, OR 97401
(503) 319-8926

KPFF 1700014.84

RECEIVED

MAY 26 2021

OWRD

RECEIVED

MAY 26 2021

OWRD