

CLAIM OF BENEFICIAL USE



Transfer T-6875

SECTION 33, TOWNSHIP 31 SOUTH, RANGE 4 WEST, W.M.
DOUGLAS COUNTY OREGON

RECEIVED

FEB 22 2021

OWRD

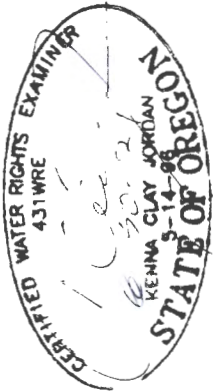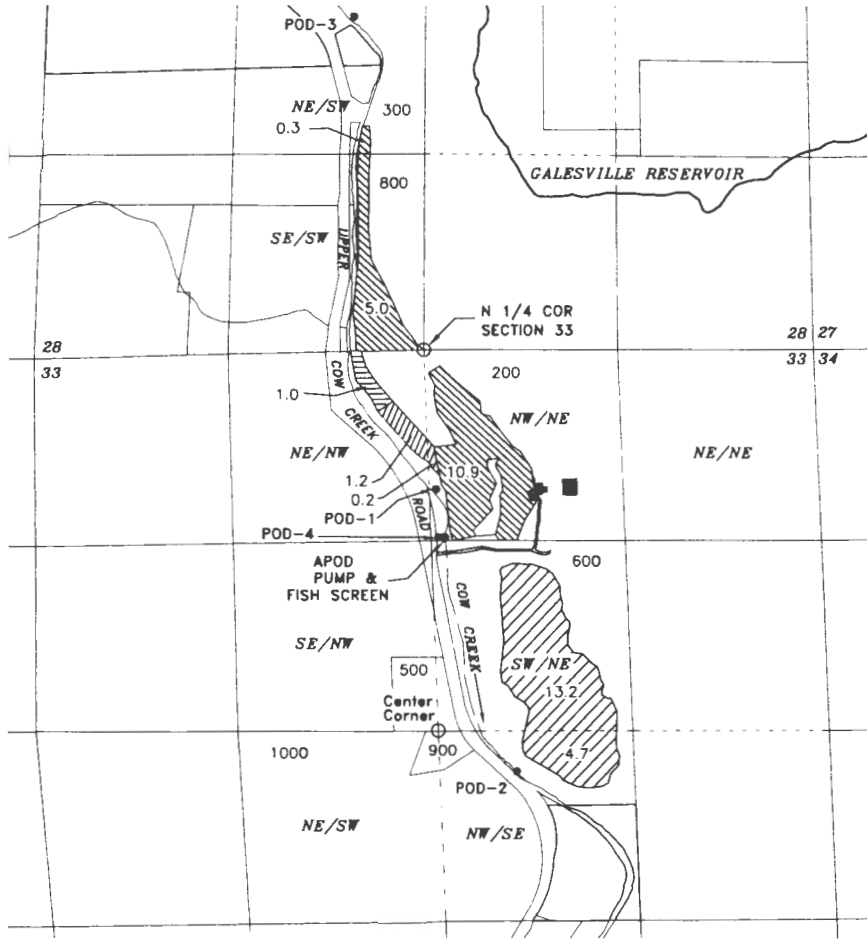

Scale
1 inch = 1320 feet

Legend

APOD* - NW/NE, Section 33 - 1304 Feet South & 91 Feet East from the North 1/4 Corner of Section 33
 POD #1* - NW/NE, Section 33 - 970 Feet South & 50 Feet East from the North 1/4 Corner of Section 33
 POD #2* - NW/SE, Section 33 - 280 Feet South & 520 Feet East from the Center 1/4 Corner of Section 33
 POD #3 - NE/SW, Section 28 - North 11° 45' West, 2350 Feet from the N 1/4 Corner of Section 33
 POD #4 - NW/NE, Section 33 - South 4° 30' East, 1300 Feet from the N 1/4 Corner of Section 33
 *As measured from the west line of the East 1/2 of Section 33 & North line of Sec. 33 or North line of the South 1/2 of Sec. 33

	Cert. 51964 - Irrigation of 15.9 Acres	APOD, and anywhere in between POD #3 & POD #4
	Cert. 67779 - Irrigation of 1.0 Acres	APOD, and anywhere in between POD #3 & POD #4
	Cert. 51966 - Irrigation of 17.9 Acres	APOD, & POD #2
	Cert. 67780 - Irrigation of 1.4 Acres	APOD, & POD #1

Prepared For:
 Geraldine Thuresson
 5907 Upper Cow Creek Road
 Azalea, OR 97410

Base map from Douglas County GIS over 6/8/94 & 5/10/19 Google aerial photo & T-6875 map for assumed best fit. Survey maps 45/225 & M6151 used for orientation & control

This map is not intended to provide legal dimensions or locations of property ownership lines

JORDAN ENGINEERING
 460 JORDAN LANE
 ROSEBURG, OREGON 97471
 (541) 673-1931
 January 9, 2021 n.e.d.