


CLAIM OF BENEFICIAL USE SURVEY TRANSFER
T-10955 IN THE NAME OF PORTLAND GENERAL
ELECTRIC COMPANY.

THE PURPOSE OF THIS MAP IS TO IDENTIFY THE LOCATION OF THE WATER RIGHT. IT IS
NOT INTENDED TO PROVIDE INFORMATION RELATIVE TO THE LOCATION OF PROPERTY
OWNERSHIP BOUNDARY LINES.

- LEGEND**
- = PLACE OF USE
 - = PUBLIC LAND SURVEY SYSTEM SECTION CORNER
 - = PUBLIC LAND SURVEY SYSTEM QUARTER CORNER
 - TL = COUNTY TAX LOT
 - - - - - = COUNTY TAX LOT LINE
 - - - - - = PUBLIC LAND SURVEY SYSTEM QUARTER SECTION LINE.
 - - - - - = DONATION LAND CLAIM LINE
 - HDPE = HIGH DENSITY POLYETHYLENE WATER LINE
 - PGE = PORTLAND GENERAL ELECTRIC COMPANY
 - = PORTLAND GENERAL ELECTRIC LEASE AREA
 - = 16" HDPE WATER LINE

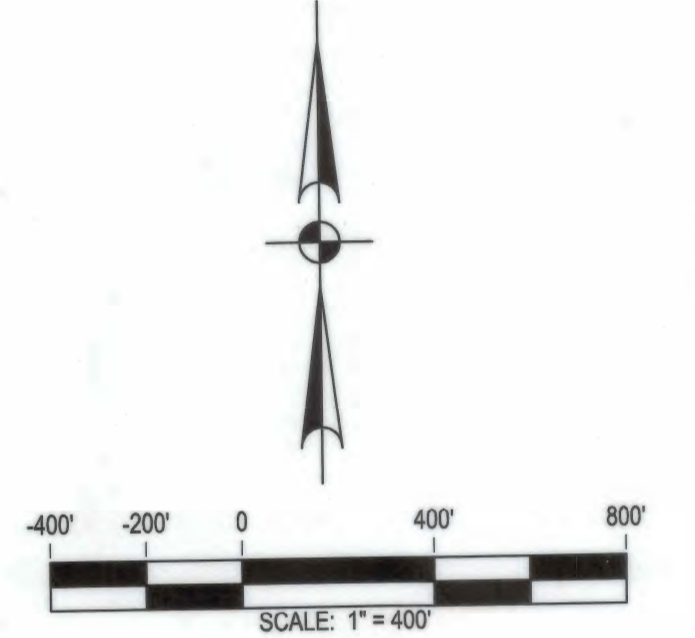

REGISTERED WATER RIGHT EXAMINER
49223
Richard J. Belliveau
RICHARD J. BELLIVEAU
JUNE 13, 2013
STATE OF OREGON
RENEWS: 12/31/2015

RECEIVED
SEP. 22 2015
OWRD

DATE: 08/19/2015	DESIGNER: RJG	CHECKED BY: RJG
DRAWN BY: BLG	DESIGN ENGR.:	ENGR. MGR.: SGH
SCALE: 1"=400'	CAD FILE NAME: PWP2-BSU-0001-R01	
PORTLAND GENERAL ELECTRIC CO. 121 SW SALMON ST. PORTLAND, OR 97204		
PORT WESTWARD CLAIM OF BENEFICIAL USE MAP FOR PGE T-10955 T. 08N., R. 04W., SEC. 15, SEC. 16 SEC 21 & SEC 22, W.M.		
DRAWING NO.:	SHEET NO.:	REV. NO.:
PWP2-BSU-0001	-R01	0

WARNING
0 1/2 1
IF THIS BAR DOES NOT MEASURE 1"
THEN DRAWING IS NOT TO SCALE

PGE Internal Use
Access Limited to PGE

COBU MAP # 936

