


CLAIM OF BENEFICIAL USE MAP


TO CHANGE PLACE OF USE AND
ADD A POINT OF APPROPRIATION
FOR T-12420
GOLDEN RULE FARMS, INC.


RECEIVED
OCT 17 2022

TOWNSHIP 27 SOUTH, RANGE 32 EAST, SECTION 6, W.M.
TAX LOTS 100 & 400

OWRD

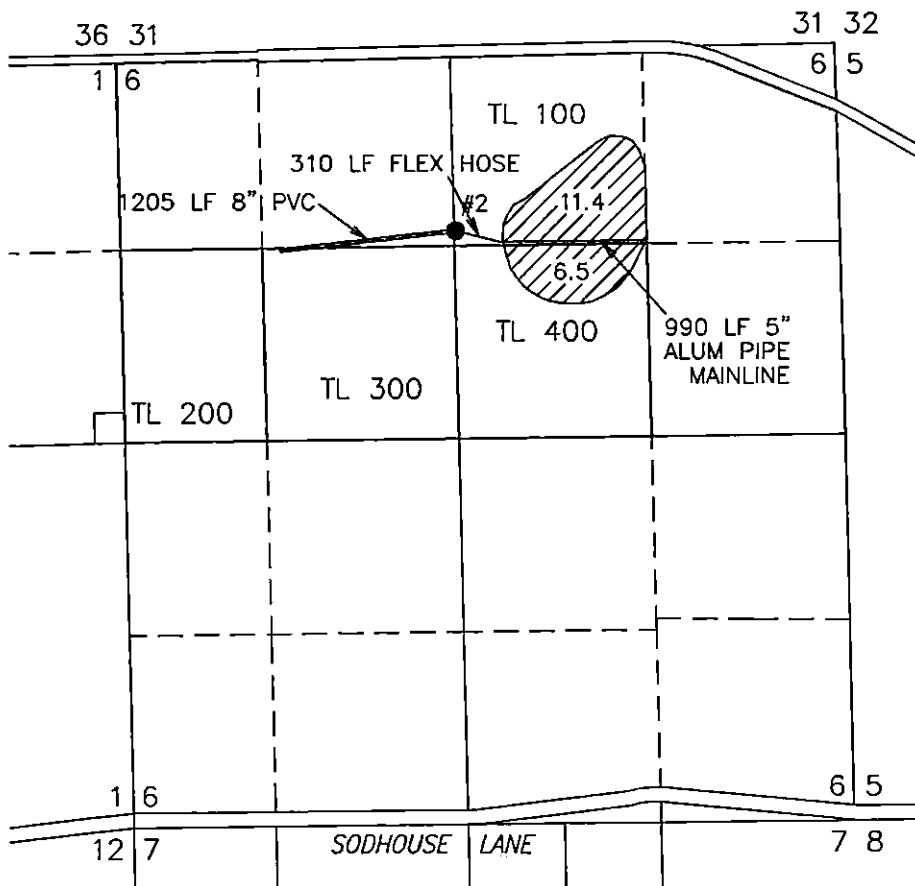

 17.9 ACRES WATER RIGHTS
FROM CERTIFICATE #39665
(G-4030), AS SHOWN.

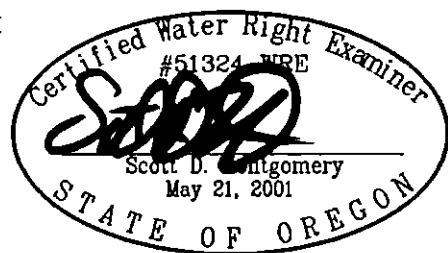

RENEWAL DATE: 12/31/2022

● **BRIGGS 2 (HARN 1460)**

EXISTING WELL IN THE NE 1/4 NW 1/4 (LOT 3)
SECTION 6, T27S R32E, W.M. LOCATED 1280 FEET
SOUTH AND 1 FEET WEST FROM THE NORTH 1/4
CORNER OF SECTION 6.

METER IS APPROXIMATELY 4.0 FEET SW'LY ALONG
DELIVERY PIPE FROM WELL.

THIS MAP IS FOR THE PURPOSE OF LOCATING A
WATER RIGHT ONLY AND HAS NO INTENT TO
PROVIDE LEGAL DIMENSIONS OR THE LOCATION OF
PROPERTY LINES

PREPARED FOR:

GOLDEN RULE FARMS, INC.
P.O. BOX 255
CHRISTMAS VALLEY, OR 97641

PREPARED BY:



ALL POINTS ENGINEERING AND SURVEYING, INC.
P.O. BOX 767
(541) 548-5833
TERREBONNE, OR 97760
www.APEandS.com