

FINAL PROOF MAP

TO ADD POINTS OF APPROPRIATION & CHANGE PLACE OF USE
FOR TRANSFER T-11585
WILKS RANCH OREGON LTD.


TOWNSHIP 14 SOUTH, RANGE 39 EAST, W.M.
TAX LOTS: 300 & 2000

RECEIVED
AUG 15 2018

OWRD



12 7
13 18
RANGE 39E
2000
RANGE 40E

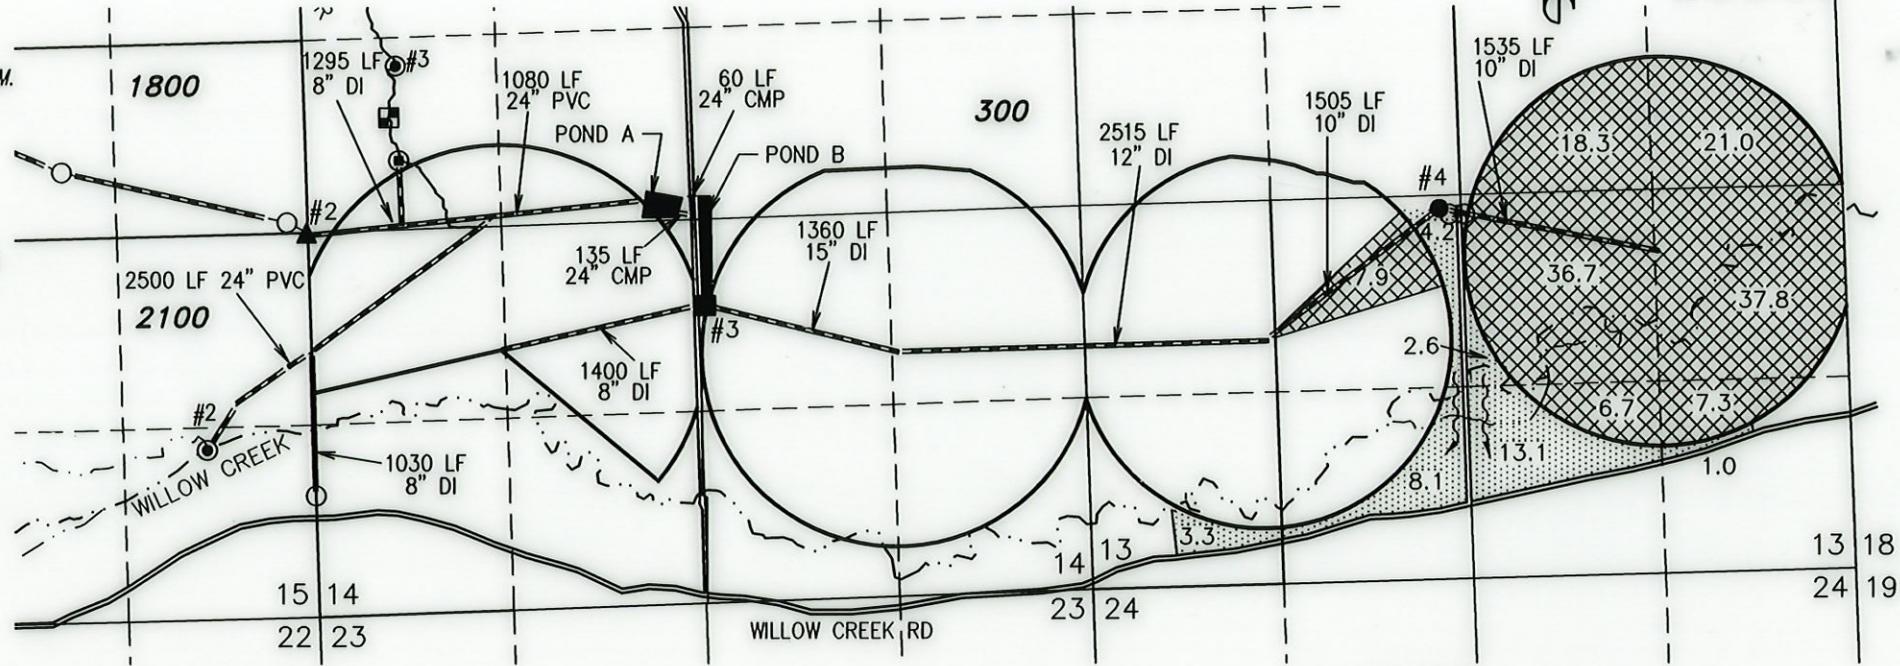

◆ SYSTEM BULGE (POND A)
LOCATED IN THE SE 1/4 NW 1/4 SECTION 14, T14S, R39E, W.M.
0.85 AF 7 FT DEEP DUGOUT POND
24" CMP INLET NW END
24" CMP OVERFLOW TO E'LY POND
24" CMP OUTLET TO E'LY POND

◆ SYSTEM BULGE (POND B)
LOCATED IN THE SE 1/4 SE 1/4 SECTION 9, T14S, R39E, W.M.
0.85 AF 7 FT DEEP PARTIALLY DUGOUT POND
24" CMP INLET NW END
(2) 12" CMP OUTLET TO N & S CANALS

▨ 135.7 ACRES SUPPLEMENTAL RIGHTS FROM
CERTIFICATE #44770 (G-4466 1969), AS SHOWN.

▩ 32.3 ACRES PRIMARY RIGHTS FROM CERTIFICATE
#44770 (G-4466 1969), AS SHOWN.

- ▲ PROPOSED POA 2 MALH 2932 (GINNY) IS LOCATED IN THE NW 1/4 SW 1/4 SECTION 14, T14S R39E, W.M. LOCATED 2620 FEET NORTH AND 0 FEET EAST FROM THE SOUTHWEST CORNER OF SECTION 14.
- EXISTING POA 4 MALH 15 & 2510 (HOWARD) IS LOCATED IN THE NE 1/4 SW 1/4 SECTION 13, T14S R39E, W.M. LOCATED 2540 FEET NORTH AND 2460 FEET EAST FROM THE SOUTHWEST CORNER OF SECTION 13.
- PROPOSED POA 3 (LANE) IS LOCATED IN THE NW 1/4 SE 1/4 SECTION 14, T14S R39E, W.M. LOCATED 2040 FEET NORTH AND 2580 FEET WEST FROM THE SOUTHEAST CORNER OF SECTION 14.



RENEWAL DATE: 12/31/2018

THIS MAP IS FOR THE PURPOSE OF LOCATING A WATER RIGHT ONLY AND HAS NO INTENT TO PROVIDE LEGAL DIMENSIONS OR THE LOCATION OF PROPERTY LINES.

--- STREAM
--- BURIED IRRIGATION PIPE
○ FLOOD RISERS

PREPARED FOR:	PREPARED BY:
WILKS RANCH OREGON LTD. 4945 WILLOW CREEK ROAD IRONSIDE, OR 97908	
	ALL POINTS ENGINEERING AND SURVEYING, INC. P.O. BOX 767 TERREBONNE, OR 97760 (541) 548-5833 www.APEandS.com