

**T26S R29E, WM,
HARNEY COUNTY, OR**



0 1,320 Feet

1" = 1320'

● Well & Meter

----- Pipeline

POU IR

Section


----- Quarter Quarter

Tax Lot

Well Locations:

Well #4 (HARN 52640/L-125153):
1920' S, 2560' E of NW Cor Sec 23

Well #5 (HARN 52807/L-134206):
2120' S, 2370' E of NW Cor Sec 23

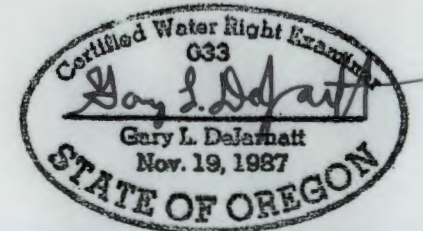


RENEWAL DATE 12/31/2021

RECEIVED

FEB 11 2021

OWRD

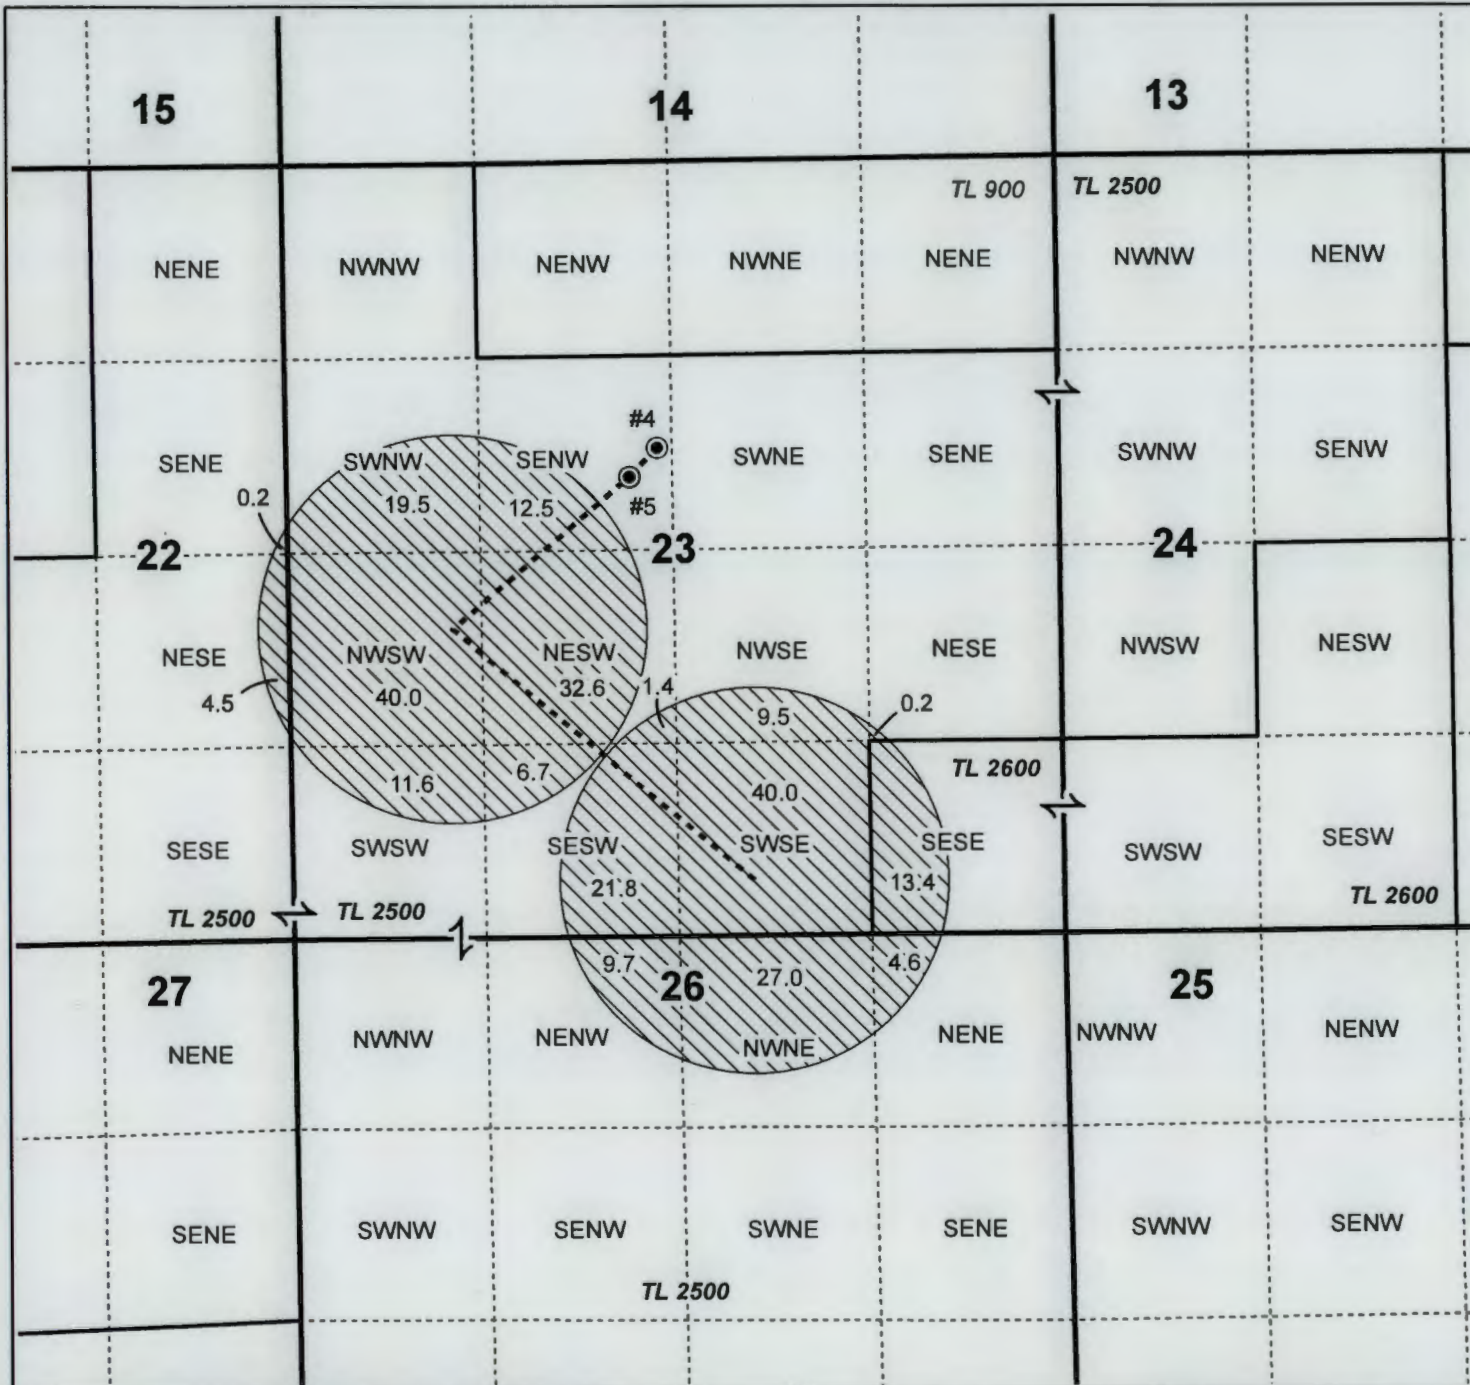

**CLAIM OF BENEFICIAL USE MAP
DJ MILLER RANCHES INC.**

This map is not intended
to provide legal dimensions
or locations of property
ownership lines.

WATER RIGHT SERVICES, LLC
PO BOX 1830, BEND, OR 97709
WWW.OREGONWATER.US CCB # 197121
johnshort@usa.com 541-389-2837