



SCALE
1" = 200 FT.




EXPIRES 6/30/2014

LEGEND

- POINT OF DIVERSION
- POLY PIPE - DIAMETER AS NOTED
- FOUND MONUMENT AS NOTED
- STAND PIPE WITH HOSE BIB
- IRRIGATED LAWN AREA (0.5± AC.)

CLAIM OF BENEFICIAL USE MAP

LOCATED IN THE SE 1/4 OF SECTION 32,
TOWNSHIP 29 SOUTH, RANGE 12 WEST, W.M., COOS COUNTY, OREGON
APPLICATION S-81717, PERMIT S-53337

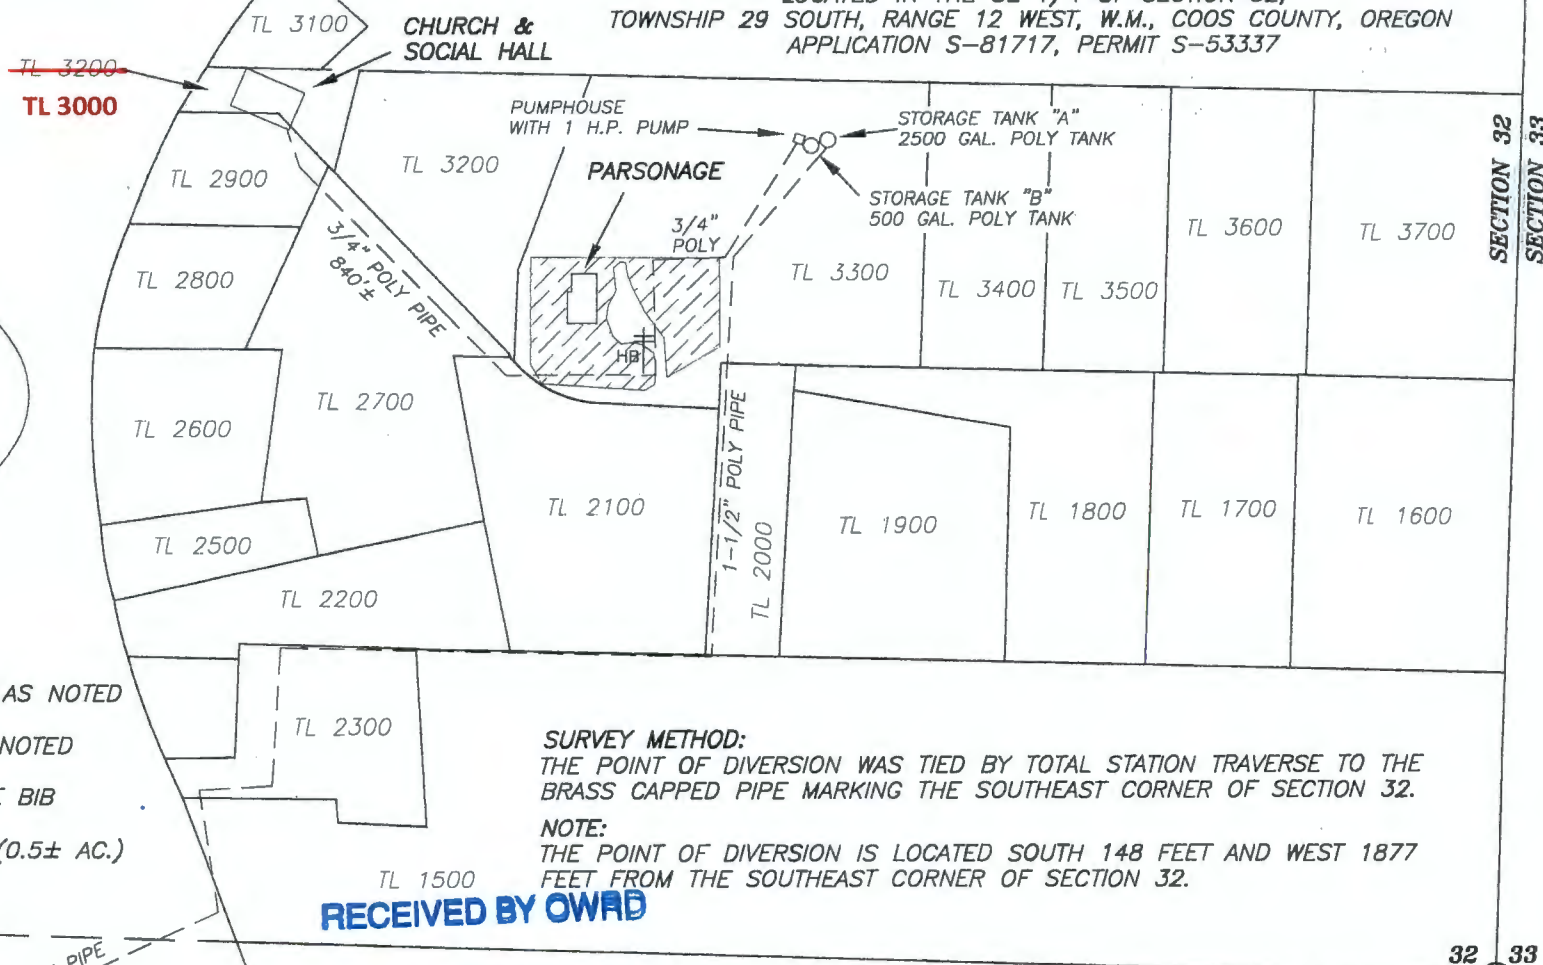

SURVEY METHOD:
THE POINT OF DIVERSION WAS TIED BY TOTAL STATION TRAVERSE TO THE BRASS CAPPED PIPE MARKING THE SOUTHEAST CORNER OF SECTION 32.


NOTE:
THE POINT OF DIVERSION IS LOCATED SOUTH 148 FEET AND WEST 1877 FEET FROM THE SOUTHEAST CORNER OF SECTION 32.

RECEIVED BY OWRD

MAY 15 2014

SALEM, OR

EXAMINER'S DISCLAIMER STATEMENT
THE PREPARATION OF THIS MAP WAS FOR THE PURPOSE OF IDENTIFYING THE LOCATION OF THE WATER RIGHT ONLY AND HAS NO INTENT TO PROVIDE DIMENSIONS OR LOCATION OF PROPERTY OWNERSHIP LINES.

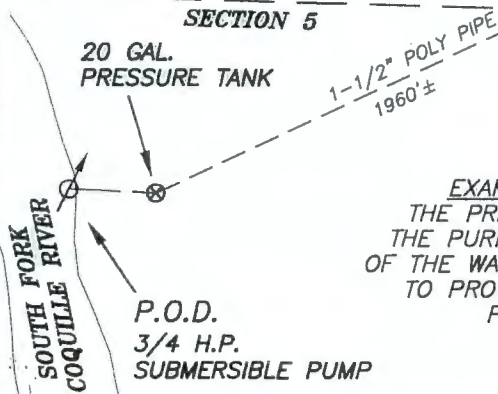

705 S. 4TH ST. PHONE: (541) 267-2872
 P.O. BOX 118 FAX: (541) 267-0588
 COOS BAY, OREGON 97420 www.stuntzner.com
 Engineering - Land Surveying - Forestry - Land Planning - Water Rights

JOB #: 114-009	PREPARED FOR:	Broadbent Community Church
DATE: April 2014		Broadbent, Oregon
DRAWN BY: CMW	CHECKED BY: CMW	FILE NAME: 114-009 Broadbent Church COBU.dwg
		SHEET 1 OF 1

SE1/4 SEC.32 T29S R12W W.M.
COOS COUNTY


29S 12W 32D

THIS MAP WAS PREPARED FOR
ASSESSMENT PURPOSE ONLY

1" = 200'
SEE MAP 29S 12W 32

CANCELLED NO.

- 2101
- 801
- 1801
- 1901
- 101
- 102

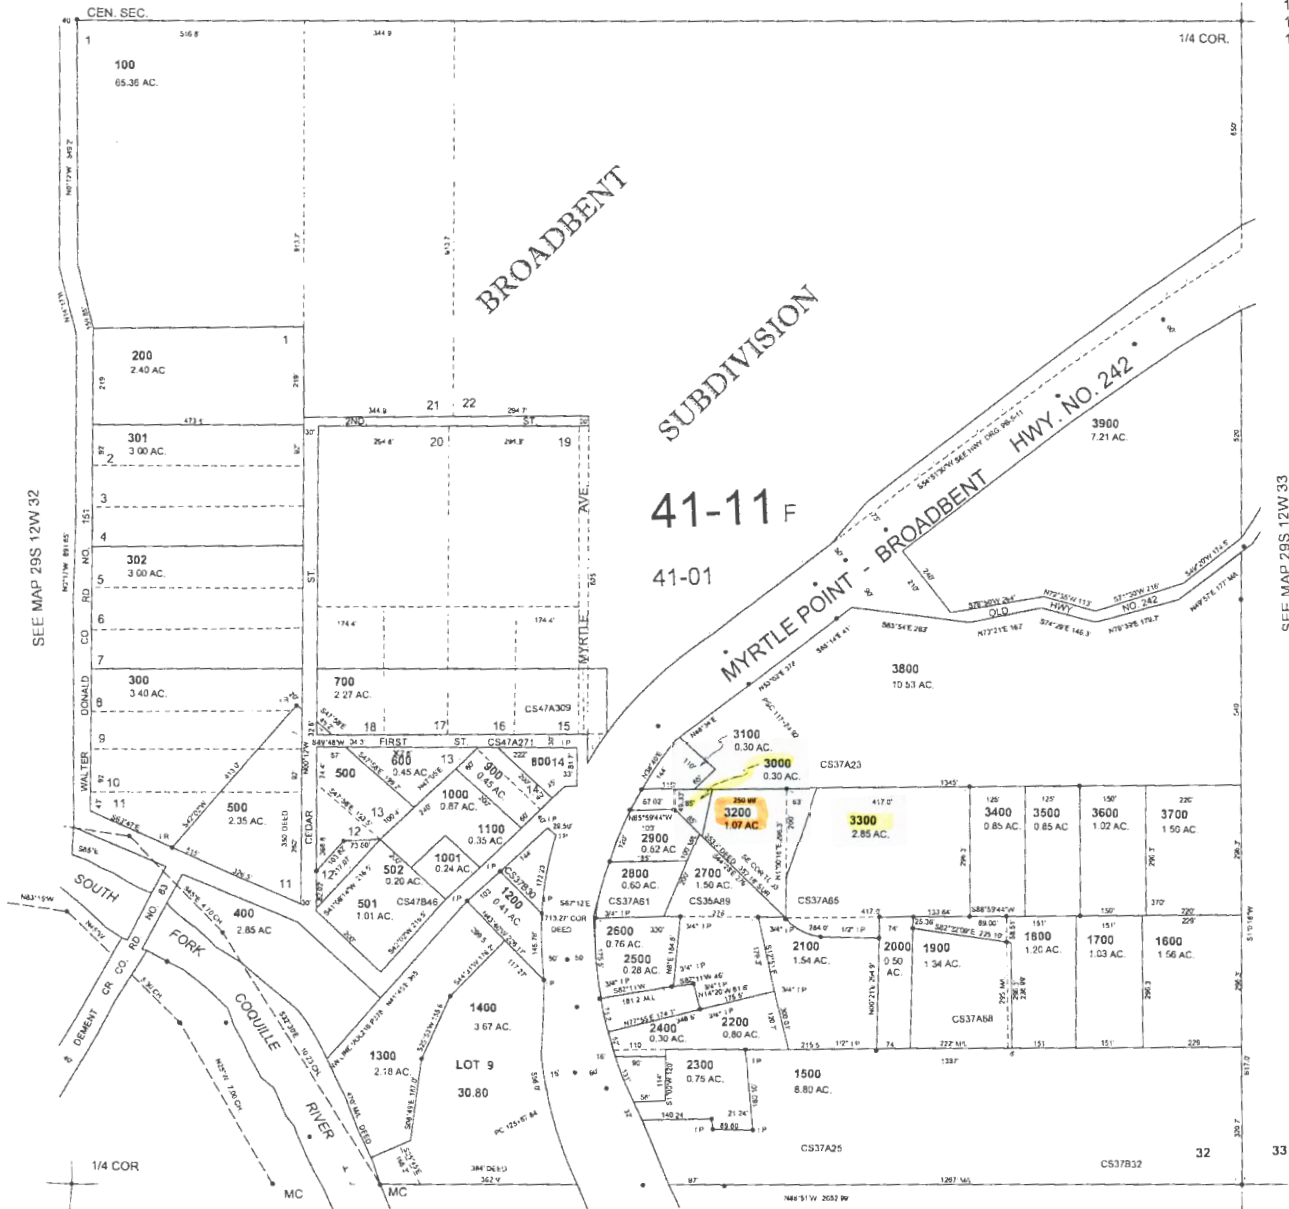

SEE MAP 29S 12W 32

SEE MAP 29S 12W 33

SEE MAP 30S 12W 05

12-2-2008

29S 12W 32D

Broad bent Community Church

RECEIVED

ITROL 1-27 LAYOUT 202 4-27 TRACED 11 4-27 CHECKED 11 7-27

NOV 15 1936

REDUCED COPY

NOT TO SCALE

WAY RESOURCES DEPT SALEM, OREGON

COPY

Map No. 81717

Permit No. 53337

CHANGES UPDATED AS OF


MAY 23 1966

town 29 Rg 12 Sec 32 D

scale: 1" = 400ft



SEE MAP 29 12 32

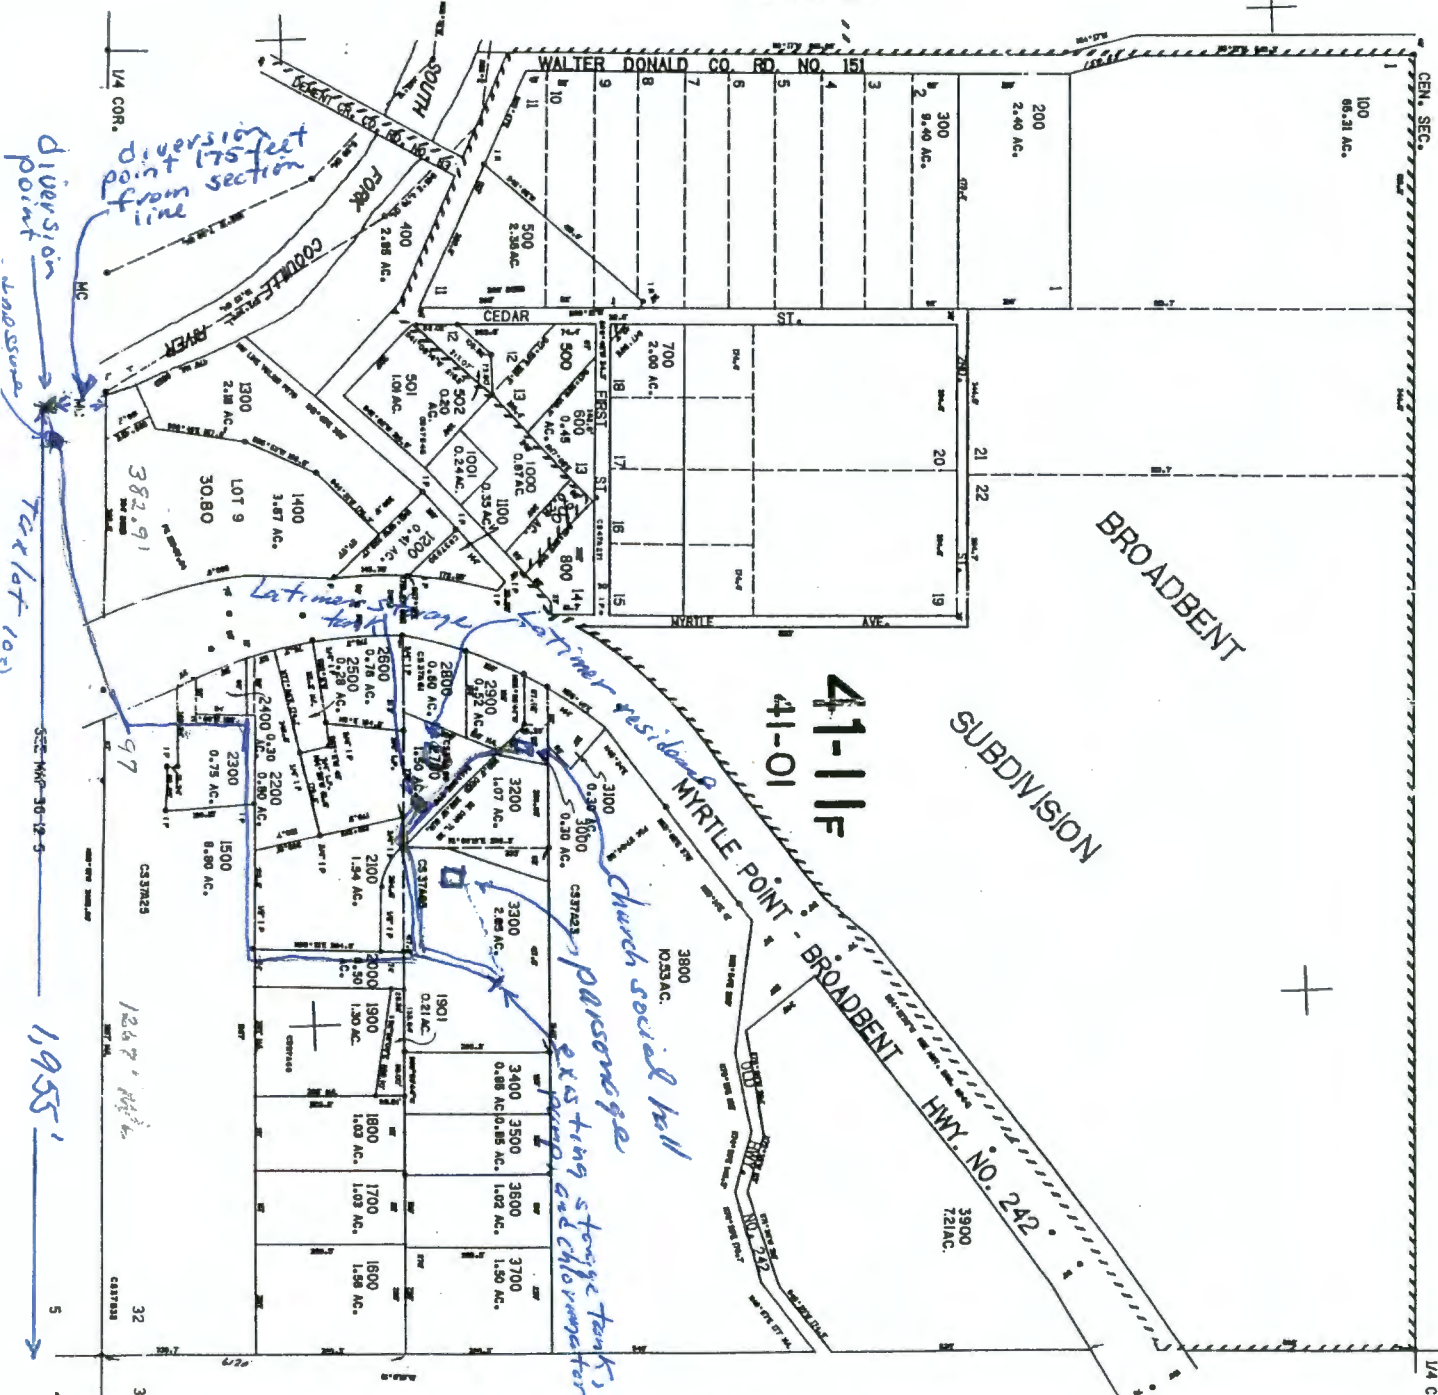

THIS MAP WAS PREPARED FOR ASSESSMENT PURPOSE ONLY.

SEE MAP 29 12 32


Diversion point: 175 feet S, 1,955 feet W of SE corner of section 32

510,000

2101