


CLAIM OF BENEFICIAL USE MAP
FOR MAK LEEK INC.

APPLN G-14931, PERMIT G-13741


SW $\frac{1}{4}$ SW $\frac{1}{4}$ SEC 5, T10S, R1W, WM

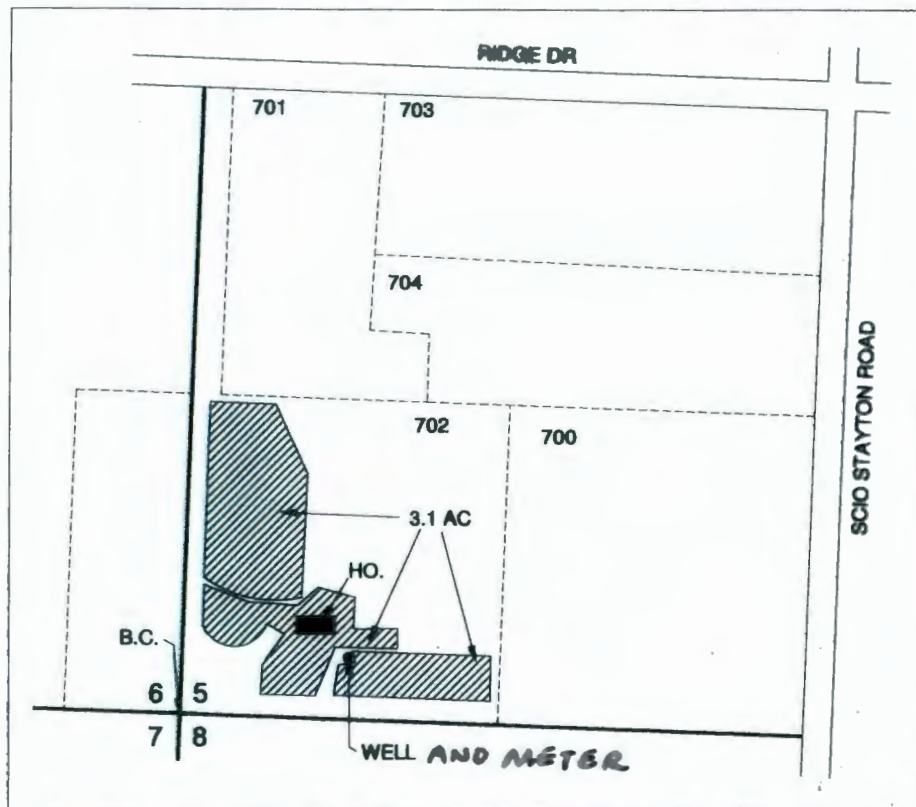

WELL IS LOCATED 115 FT NORTH AND 350 FT EAST FROM THE SW COR SEC 5

LEGEND
Tax Lot Lines -----
Irrigation Area 
Section Lines ————

THIS MAP IS NOT INTENDED TO PROVIDE
LEGAL DIMENSIONS OR LOCATIONS OF
PROPERTY OWNERSHIP LINES.

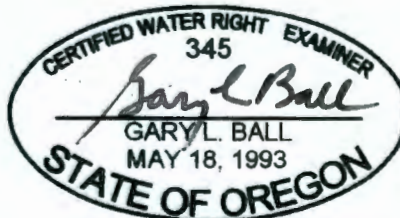

RENEWES: 12/31/2015



STATE PLANE GRID NORTH
1 INCH = 400 FEET