

**FINAL PROOF SURVEY**  
portions of Sections 30 & 31, T16S, R44E, W.M.

**DISCLAIMER**

THIS MAP IS FOR THE PURPOSE OF IDENTIFYING THE LOCATION OF THE WATER RIGHT ONLY, AND HAS NO INTENT TO PROVIDE DIMENSIONS OR LOCATION OF PROPERTY OWNERSHIP LINES.

**RECEIVED**

**JAN 28 1999**

WATER RESOURCES DEPT.  
SALEM, OREGON



APPLICATION No.: G-12773

PERMIT No.: G-11939

EXISTING PERMITS : VALE IRRIGATION DISTRICT

**LEGEND**



GOVERNMENT CORNER

SUPPLEMENTAL RIGHT

CONC. LINED DITCH

EARTH DITCH

WELL

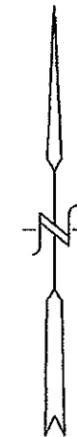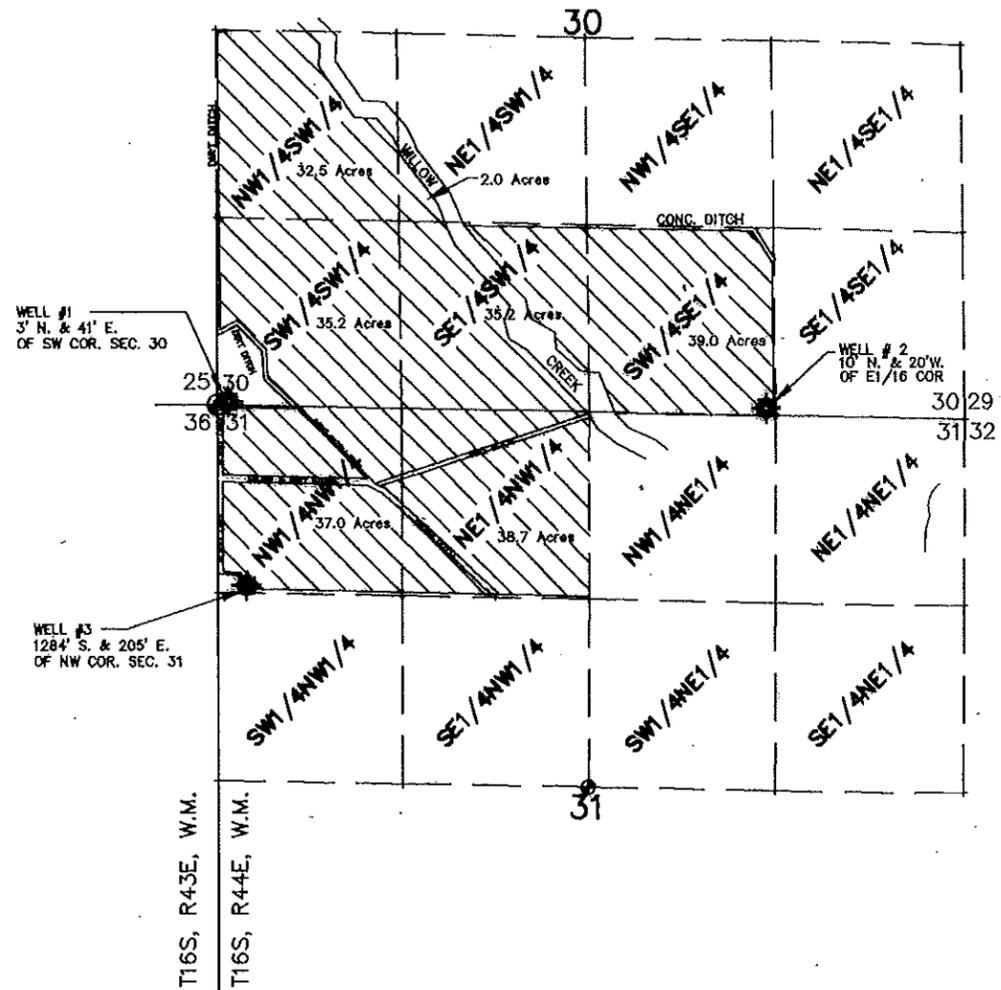

SCALE: 1" = 1320'

FINAL PROOF SURVEY		
FOR : <i>SCOTT LIVESTOCK COMPANY</i>		
<b>EDWARDS &amp; CUMMINGS, LLC</b>		
156 SE 1st AVE. ONTARIO, OR. 97914 (541) 889-2101		
CHECKED BY: LLM	DRAWN BY: RGH	APPROVED BY: LLM
DATE: 1/21/99	DRAWING No. WO98354-A592	REVISED:
SHEET 1 OF 1	JOB No. WO-7391	BK.WO-08 PG.8