


Permanent Transfer for Del Strubhar - 2023

Ground Water C 65236 POU



T. 4S., R. 1W., W.M.

EXPIRES: 2023.12.31

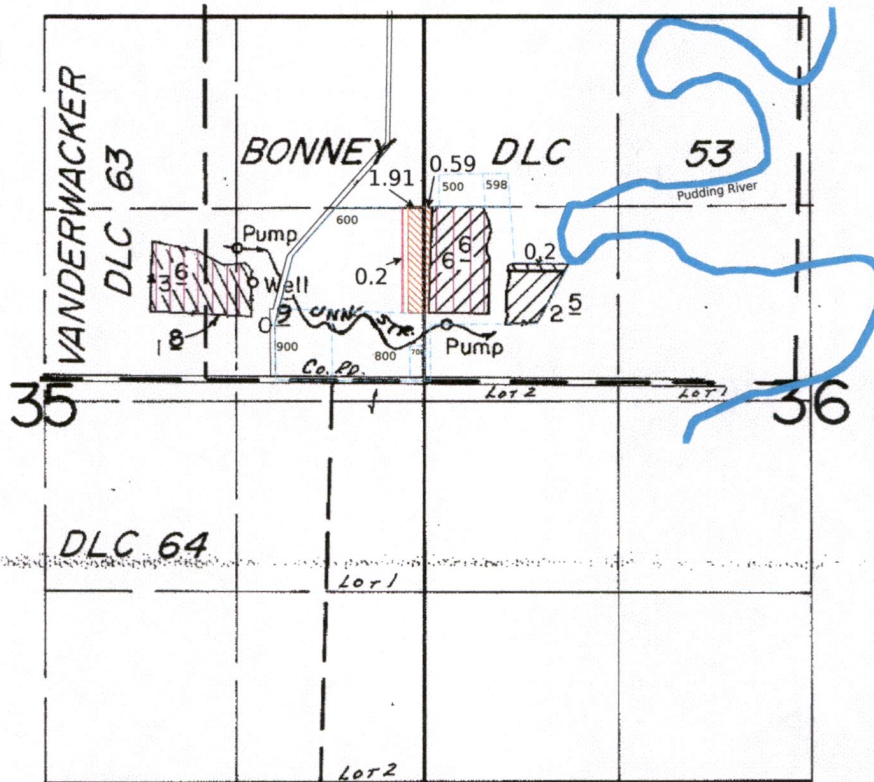

Legend

FROM

- PRIMARY
- SUPPLEMENTAL

TO

- Primary
- Supplemental

Not part of this
Transfer

FINAL PROOF SURVEY

UNDER

Application No. G-8357, Permit No. G-7862, C 65236
IN NAME OF

WILLIAM N. STRUBHAR

Surveyed May 8, 1984, by B.W. BISHOP


RECEIVED

APR 13 2023

OWRD

PREPARATION OF THIS MAP IS FOR THE PURPOSE OF IDENTIFYING THE LOCATION OF THE WATER RIGHT ONLY. THERE IS NO INTENT TO PROVIDE DIMENSIONS OR LOCATION OF PROPERTY OWNERSHIP LINES.

T. 4S., R. 1W., W.M.

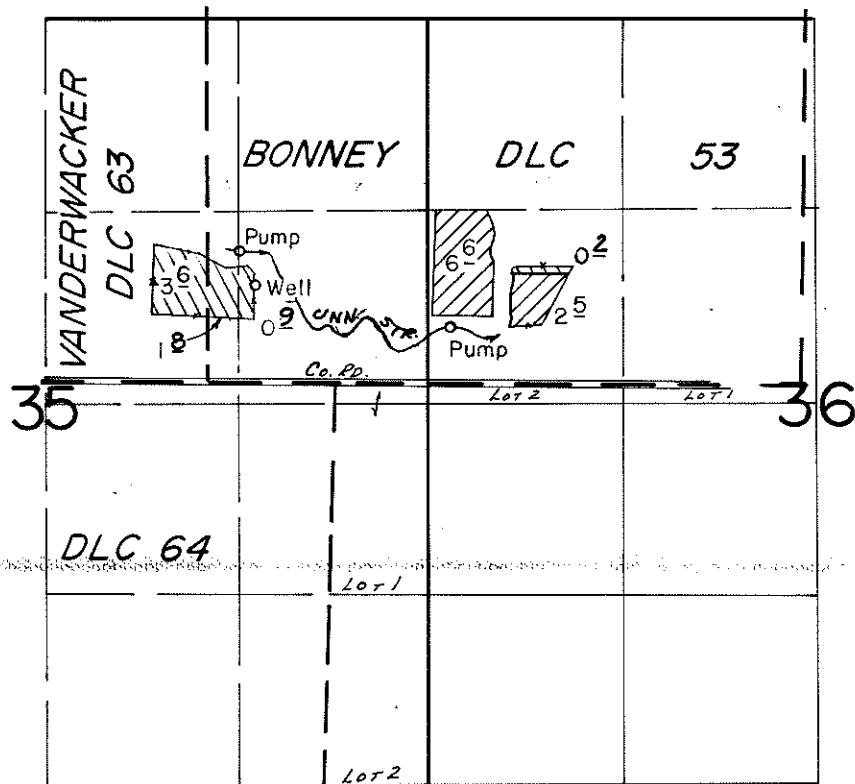

WELL LOC.: 680' N. & 330' E. FROM SW COR. BONNEY DLC 53.


REDIVERSION: 390' N. & 1680' E.; 900' N. & 210' E. BOTH

FROM SW COR. DLC 53

SCALE: 1" = 1320'



PRIMARY

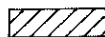

SUPPLEMENTAL

FINAL PROOF SURVEY

UNDER

Application No. G-8357. Permit No. G-7862....
IN NAME OF

.....WILLIAM N. STRUBHAR.....

Surveyed May 8, 1984, by B.W. BISHOP.....