


Rodney & Marie Lyon Claim Of Beneficial Use Map T-13355

T 40 S, R 12 E,
Section 34 & 35
T 41 S, R 12 E,
Sections 2 & 3

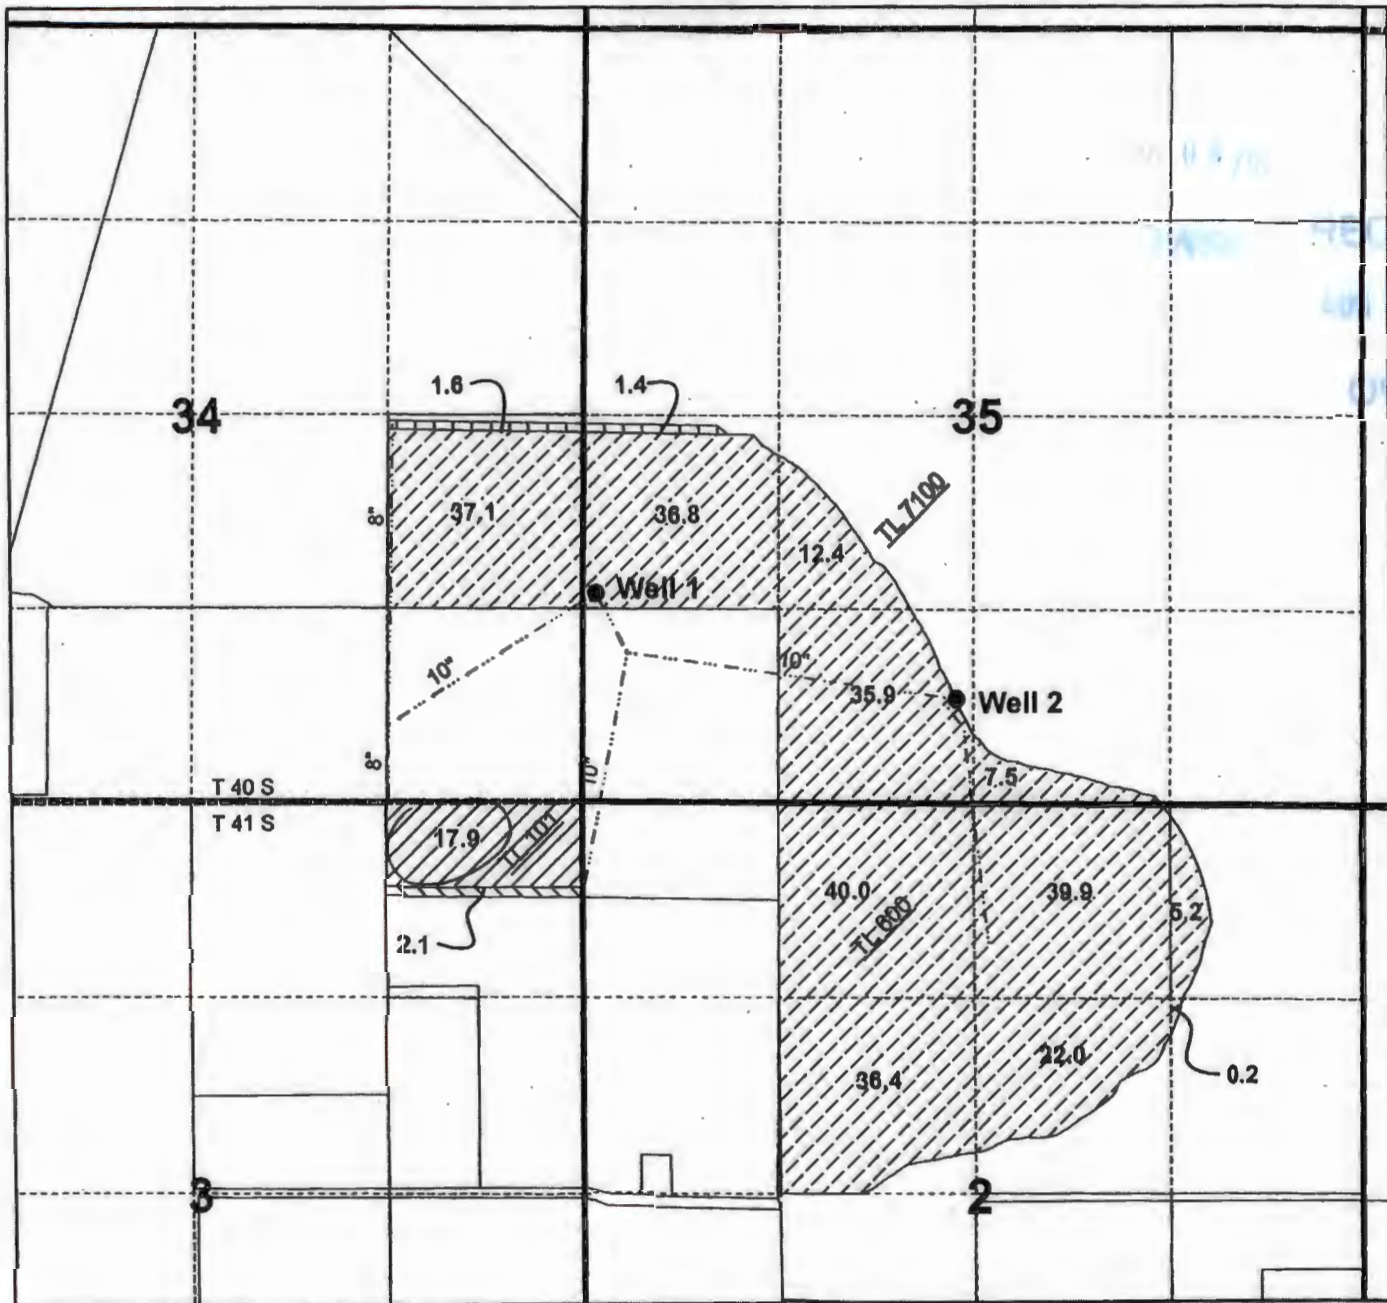

Legend

- T-13355 (67582) Primary 3.0 Ac Use Well 1 & 2
- T-13355 (67582) Supp 2.1 Ac Use Well 1 & 2
- T-13355 (67582) add POA Well 1 only 273.4 ac
- T-13355 (91653) Supp 17.9

● Wells



1 inch = 1,320 feet

Note: This map is not intended to provide legal dimensions or locations of property ownership lines.

Well 1 located North 1420 ft & East 100 ft
Fm the Southwest Cor. Sec 35
Within NWSW, Sec 35, T40S, R12E, WM

Well 2 located North 750 ft & East 2550 ft
Fm the Southwest Cor. Sec 35
Within SESW, Sec 35, T40S, R12E, WM

