

**CLAIM OF BENEFICIAL USE**

APPLICATION # G-15903 & PERMIT #G-15694  
 FOR: MOUNT BACHELOR VILLAGE ASSOCIATION  
 LOCATED IN: PORTIONS OF THE SE 1/4, SW 1/4 &  
 SW 1/4, SE 1/4 OF SEC. 6 AND THE NE 1/4,  
 NW 1/4, & NW 1/4, NE 1/4 & SE 1/4, NW 1/4  
 & GOV'T LOT 2 OF SEC. 7, T.18 S., R12 E.,  
 W.M., CITY OF BEND, DESCHUTES COUNTY, OREGON

**RECEIVED**

OCT 01 2008

WATER RESOURCES DEPT  
 SALEM, OREGON


LOT  
7

SE1/4  
SW1/4

SW1/4  
SE1/4

NOTE:  
 THE PREPARATION OF THIS MAP IS FOR THE  
 PURPOSE OF IDENTIFYING THE LOCATION OF  
 THE WATER RIGHT ONLY AND HAS NO INTENT  
 TO PROVIDE DIMENSIONS FOR LOCATION OF  
 PROPERTY OWNERSHIP LINES.

SECTION 6  
SECTION 7

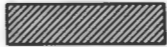

IRRIGATED AREA OF  
BENEFICIAL USE

LOT  
1

PREPARED BY



**BUSSARD WILLIAMS**

698 NW YORK DRIVE  
 BEND, OREGON 97701  
 PHONE: (541) 389-9351

1" = 400'

3.7 AC

NE1/4  
NW1/4

1.8 AC

NW1/4  
NE1/4

3.4 AC

LOT  
2


EXISTING WELL BEARS:  
 SOUTH 2055' &  
 WEST 1230' FROM  
 NORTH 1/4 CORNER  
 OF SECTION 7

9.4 AC

SW1/4  
NE1/4

LOT  
3

NE1/4  
SW1/4

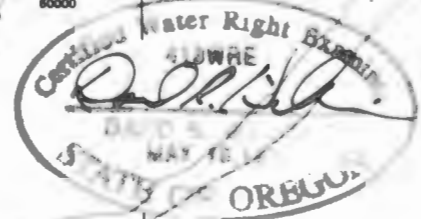

9/31/08