

CLAIM OF BENEFICIAL USE MAP

APPLICATION: G-14244


PERMIT: G-13058

FOR
WARREN C. AND JESSE E. LAIRD


SURVEYED 9/10/2001

LOCATED IN SECTION 4
TOWNSHIP 36 SOUTH, RANGE 24 EAST, W.M.,
LAKE COUNTY, OREGON

EXISTING WELL, LOCATED IN THE
WARNER LAKE BASIN;
P.O.A. LOCATED SOUTH 11 FEET
AND EAST 13 FEET FROM THE
NORTH 1/4 CORNER OF SECTION 4.

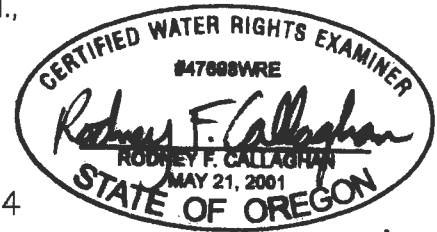

RE-NEW: 12/31/01

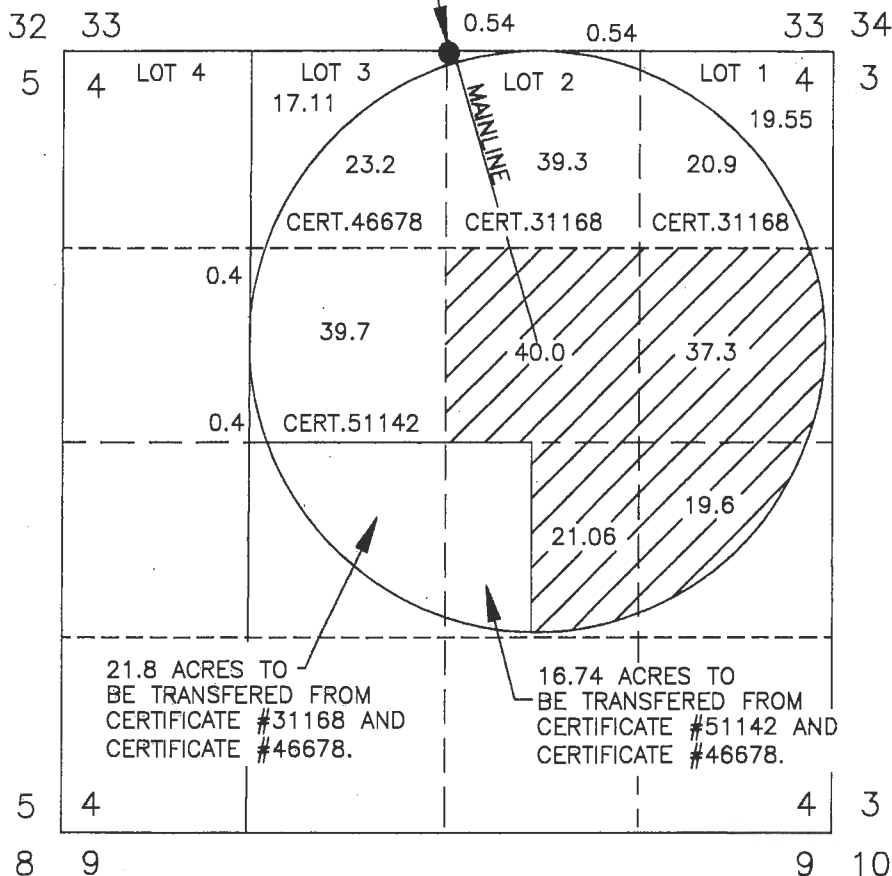

LEGEND



117.96 ACRES BEING
IRRIGATED AS PER
PERMIT G13058.

RECEIVED

SEP 21 2001

WATER RESOURCES DEPT.
SALEM, OREGON



SCALE 1"=1320'

THIS MAP IS FOR THE PURPOSE OF LOCATING A
WATER RIGHT ONLY AND HAS NO INTENT TO PROVIDE
LEGAL DIMENSIONS OR THE LOCATION OF
PROPERTY LINES.

PREPARED FOR: WARREN C. AND JESSE E. LAIRD
P.O. BOX 13
PLUSH, OR 97637

PREPARED BY:

CLS

CALLAGHAN LAND SURVEYING
427 SOUTH H STREET
LAKEVIEW, OR 97630
(541) 947-5841

DATE: 9/10/01

DRAWING: 200143