



FINAL PROOF MAP

IN THE NAME OF FESSLER FAMILY LLC
by Thomas Fessler
Application G-15041 Permit G-13850
T 5 S, R 1 W, W.M. Section 28 & 33

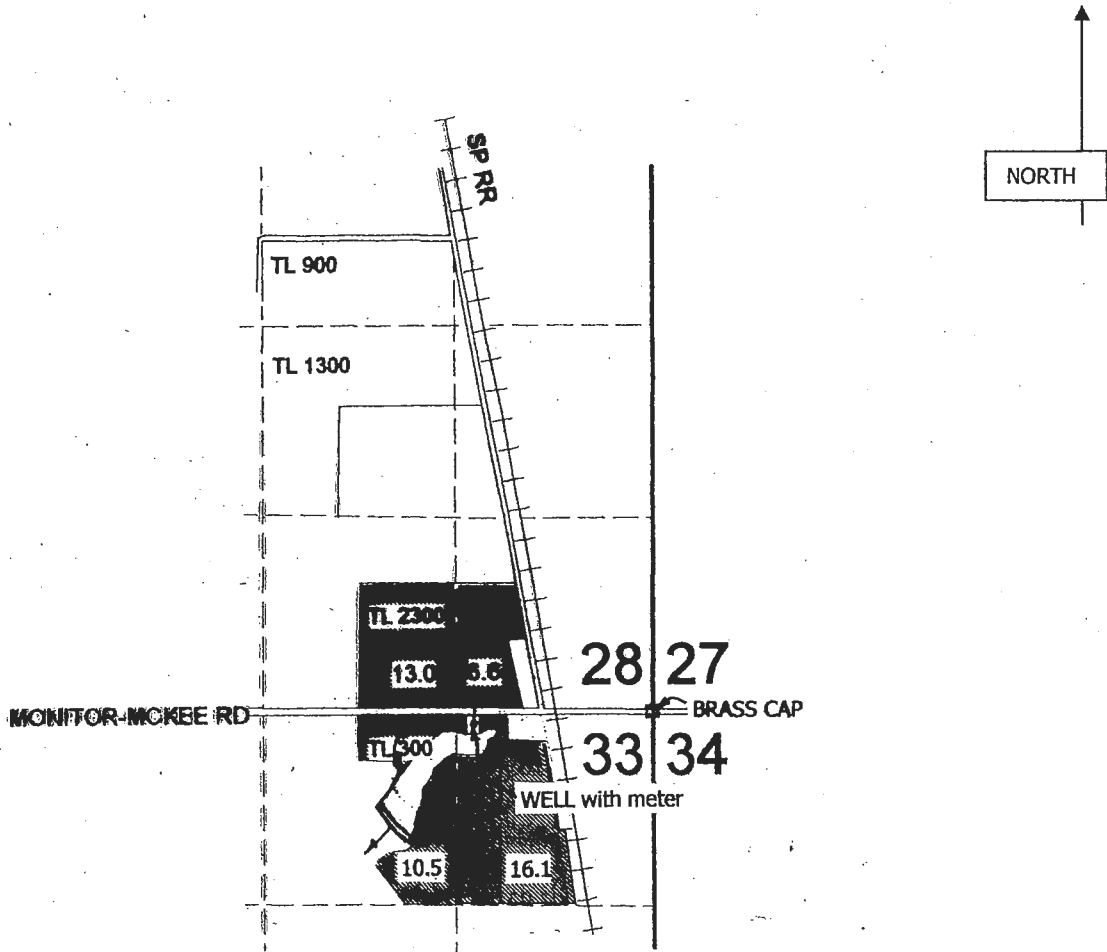

Pump with meter: 70' S & 1210' W of the NE corner Sec. 33

Scale 1" = 1320'

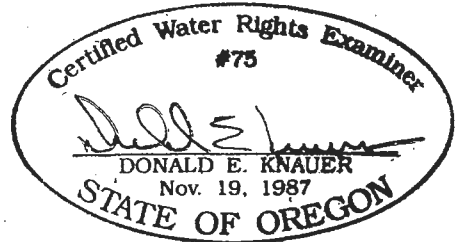

This map is not intended to provide legal dimensions or locations of property ownership lines.

RENEWAL DATE: 6/30/2011