


RECEIVED


AUG 19 2004

WATER RESOURCES DEPT
SALEM, OREGON

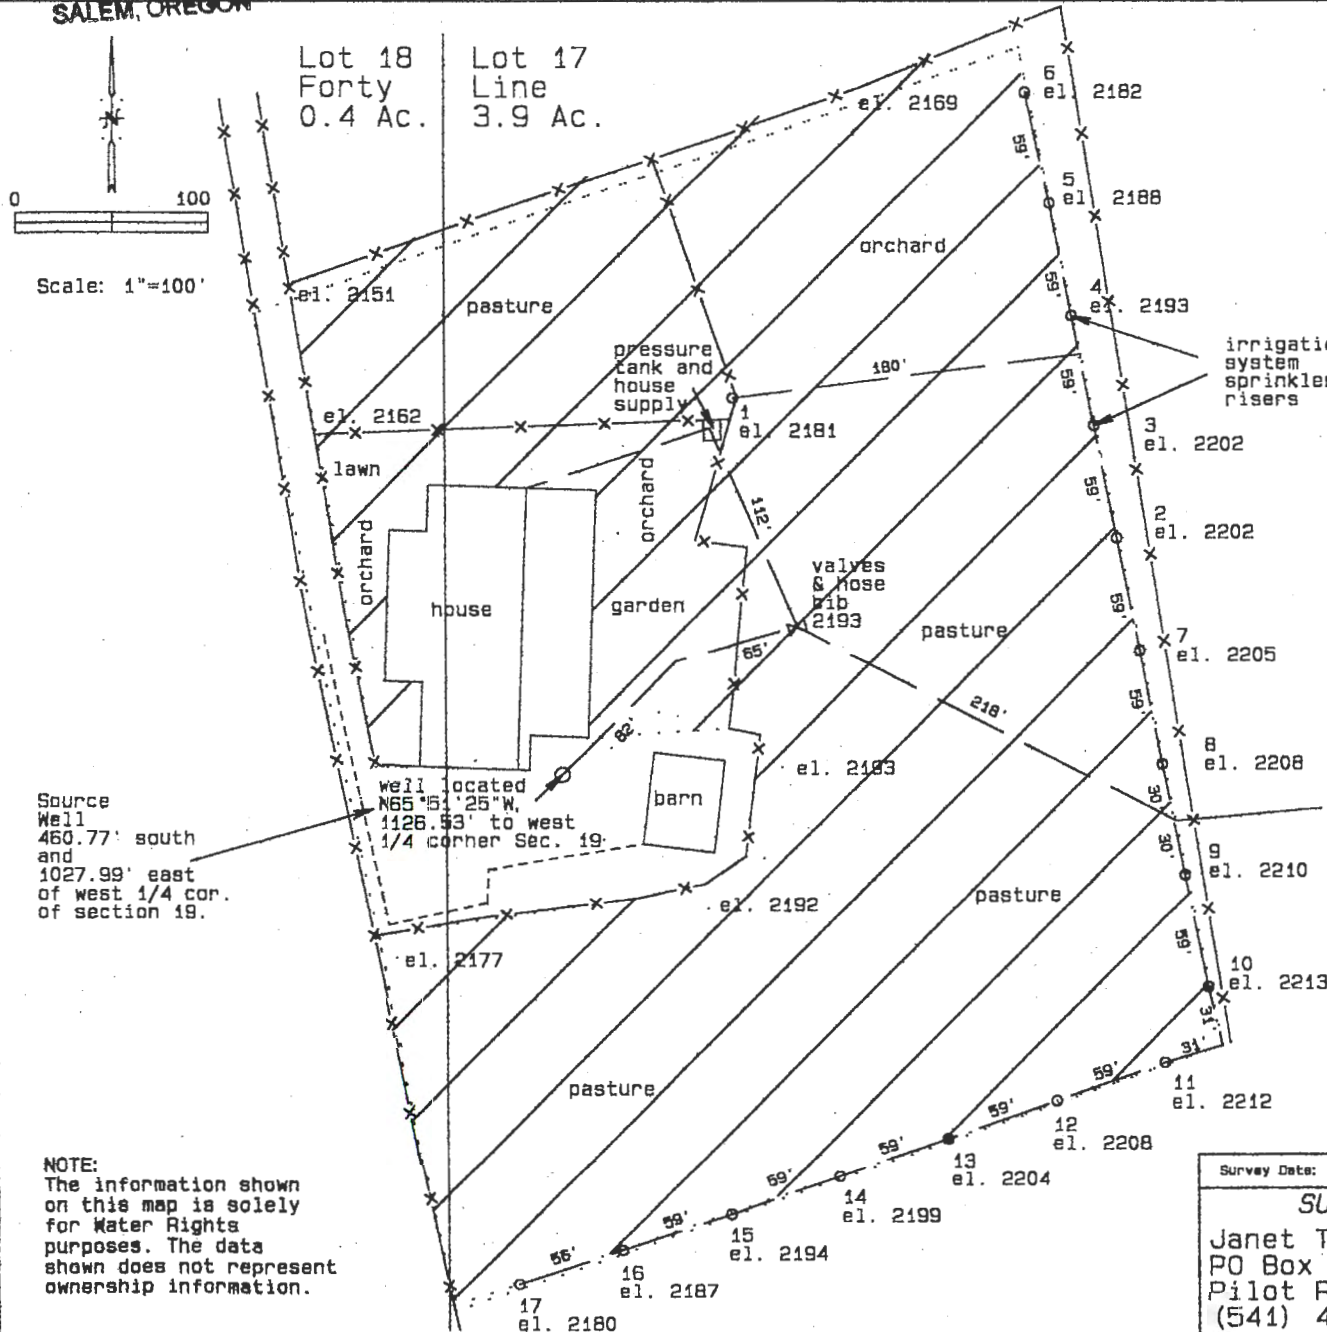

FINAL PROOF SURVEY
Application G-15257
Permit G-13992
T. 1 S., R. 33 E., W. M.
Tax Map 1S 33
Tax Lot 3501

4.2 irrigated acres. 0.8 acres
buildings and driveway.
Distribution System
Well submersible pump
with Berkely 3 HP motor.
Underground pipeline is 2" PVC with risers.
Above ground system is 3" Aluminum handline.
6 20' pieces, 8 40' pieces.
Sprinklers are Rainbird F33 with
Nelson 1/8" nozzles on 2' high risers.
This system is capable of applying more
25.77 gpm or .0574 cfs.
Permit G-13992 allowed .063 cfs on 5.0 acres.

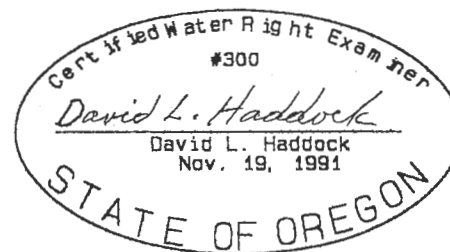

(renews 6-30-05)

NOTE:
The information shown
on this map is solely
for Water Rights
purposes. The data
shown does not represent
ownership information.

Survey Date: June 17, 2004

SURVEY FOR

Janet T. Haddock
PO Box 376
Pilot Rock, OR 97868
(541) 433-2920

David L. Haddock, Surveyor and Engineer
P.O. Box 1574
Pendleton, Oregon 97801
(541) 278-2174

HADDOCK SURVEYING

GPS
AND
TOTAL STATION