


SECTION 34, T.12S., R.26E.

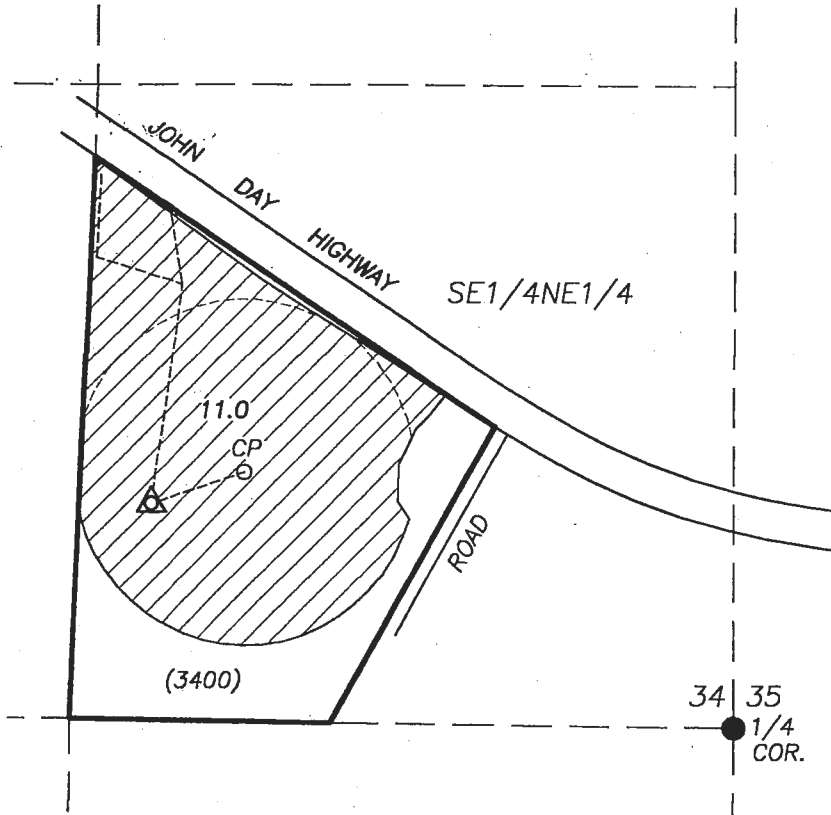

SCALE 1"=400'

RECEIVED BY OWRD

JAN 04 2016

SALEM, OR

△ POA - WELL & FLOW METER 460' NORTH & 1210' WEST OF THE E1/4 CORNER SECTION 34, T.12S., R.26E.

CP
○ CENTER PIVOT

▨ PLACE OF USE

----- MAINLINE

() TAX LOT NUMBER

● FOUND BRASS CAP

**FINAL PROOF SURVEY
UNDER
APPLICATION NO. G-17126
PERMIT G-16594**

IN NAME OF
MARK AND YOLONDA BROWN

PREPARED BY

ROBERT D. BAGETT
217 N. CANYON BLVD.
JOHN DAY, OR. 97845
APRIL 1, 2015



RENEWS 12/31/2017

THIS MAP IS NOT INTENDED TO PROVIDE LEGAL DIMENSIONS OR LOCATIONS OF PROPERTY OWNERSHIP LINES.