

Application No. 53735


Permit No. 40354

Don McQuinn

RECEIVED

OCT 30 1975

WATER RESOURCES DEPT.
SALEM, OREGON

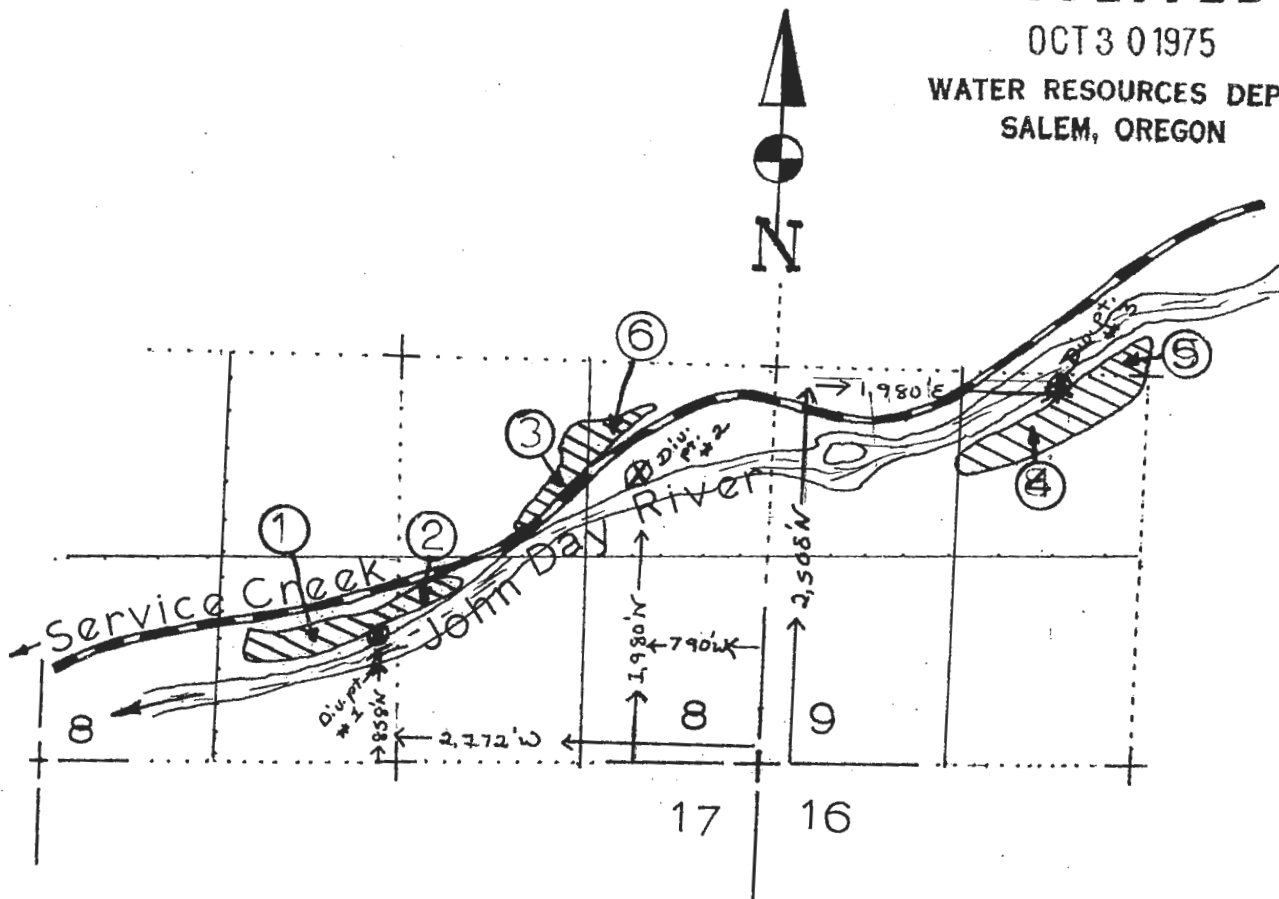

no.	acre	tnshp	range	subdiv	sec
1	3.4	9S	23E	SE $\frac{1}{4}$ SW $\frac{1}{4}$	8
2	1.1	"	"	SW $\frac{1}{4}$ SE $\frac{1}{4}$	"
3	1.8	"	"	NW $\frac{1}{4}$ SE $\frac{1}{4}$	"
4	8.0	"	"	NE $\frac{1}{4}$ SW $\frac{1}{4}$	9
5	1.1	"	"	SE $\frac{1}{4}$ NW $\frac{1}{4}$	"
6	0.6	"	"	NE $\frac{1}{4}$ SE $\frac{1}{4}$	8