
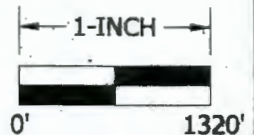


COBU - POND #3 APPLICATION R-87397 PERMIT R-14785

SE 1/4 SEC. 5, T. 12 S., R. 1 W., W.M.
LINN COUNTY, OREGON

SCALE: 1" = 1320'

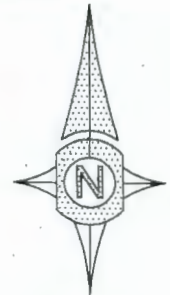


OWNER:
ALTON E. SULLIVAN
P.O. BOX 2118
LEBANON, OR. 97355

ENGINEER/SURVEYOR:
BRIAN VANDETTA
UDELL ENGINEERING & LAND SURVEYING, LLC
63 E. ASH STREET
LEBANON, OR. 97355

WATER RIGHTS EXAMINER:
ENVIROLOGIC RESOURCES, INC.
P.O. BOX 86762
PORTLAND, OREGON 97280

PROPERTY SUMMARY POND #3:
MAP 12S-1W-5
TAX LOT 200 AND 400

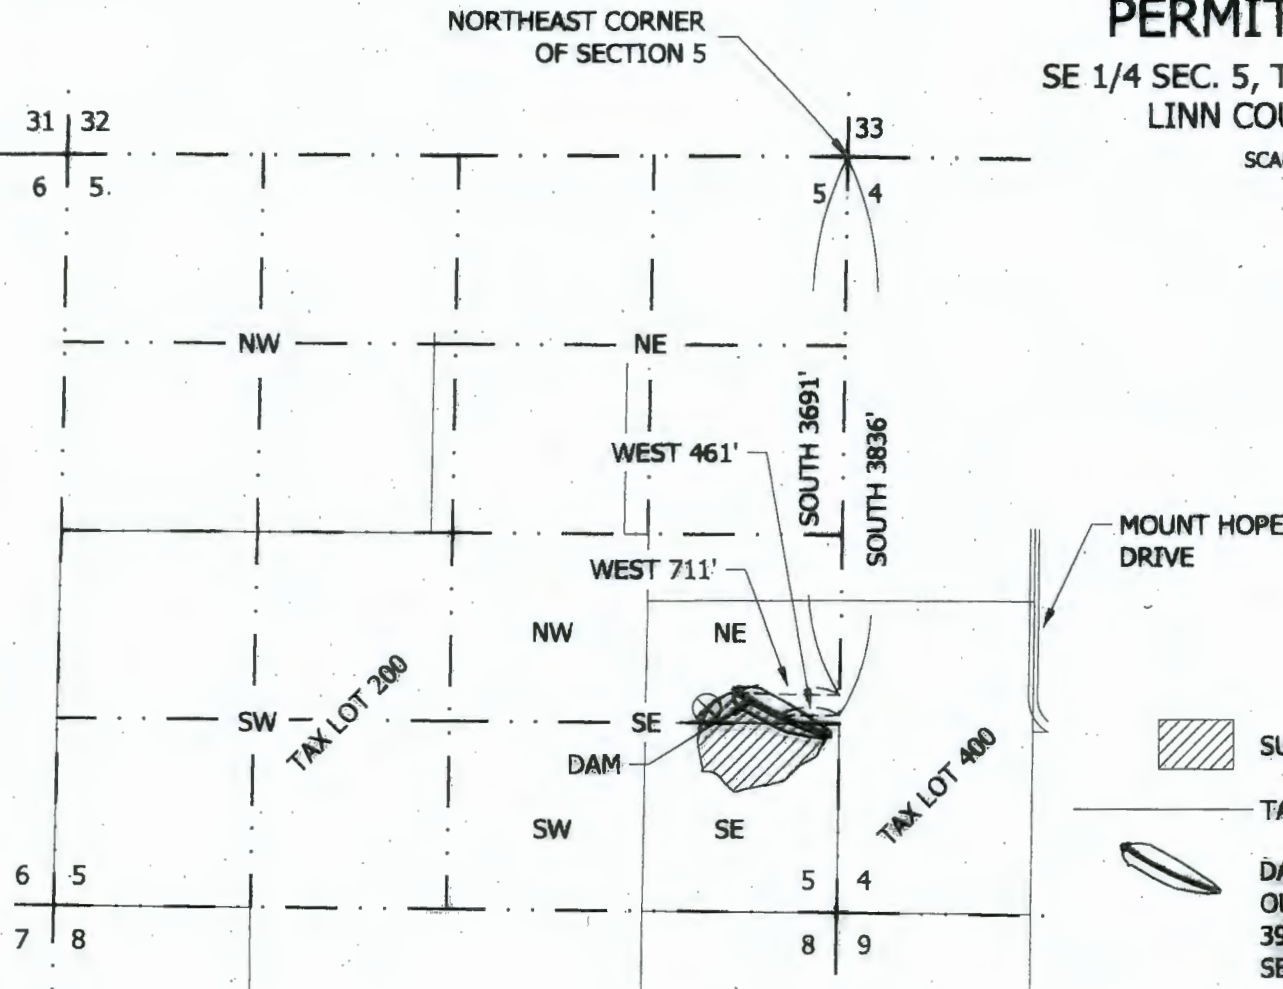

SURFACE OF POND = (8.36 ACRES)

TAX LOT LINE



DAM WITH OUTFALL STRUCTURE
OUTFALL STRUCTURE 711' WEST,
3961' SOUTH OF NE CORNER OF
SECTION 5.



STAFF GAUGE.
11 FEET READING
CORRESPONDS TO
ELEVATION OF 451 FEET

RECEIVED

DEC 20 2021

OWRD

NOTE:

MAP IS FOR THE PURPOSE OF IDENTIFYING LOCATION
OF WATER RIGHT AND IS NOT INTENDED TO PROVIDE
LEGAL DIMENSIONS OR LOCATIONS OF PROPERTY
OWNERSHIP LINES.



12/21/21

Udell

**ENGINEERING &
LAND SURVEYING, LLC**
63 EAST ASH ST.
LEBANON, OREGON
97355

PH. (541) 451-5125
FAX (541) 451-1366

08-155 SULLIVAN RESERVOIR WTR RTS