

CLAIM OF BENEFICIAL USE MAP

TO ADD POINTS OF APPROPRIATION
FOR APPLICATION T-13202
JUNIPER BASIN RANCH, LLC

TOWNSHIP 25 SOUTH, RANGE 31 EAST, SECTIONS 18 & 19, W.M.
TAX LOTS: 3600, 3700 & 3800


RECEIVED

6 25 2021

RECEIVED

AUG 04 2021

OWRD

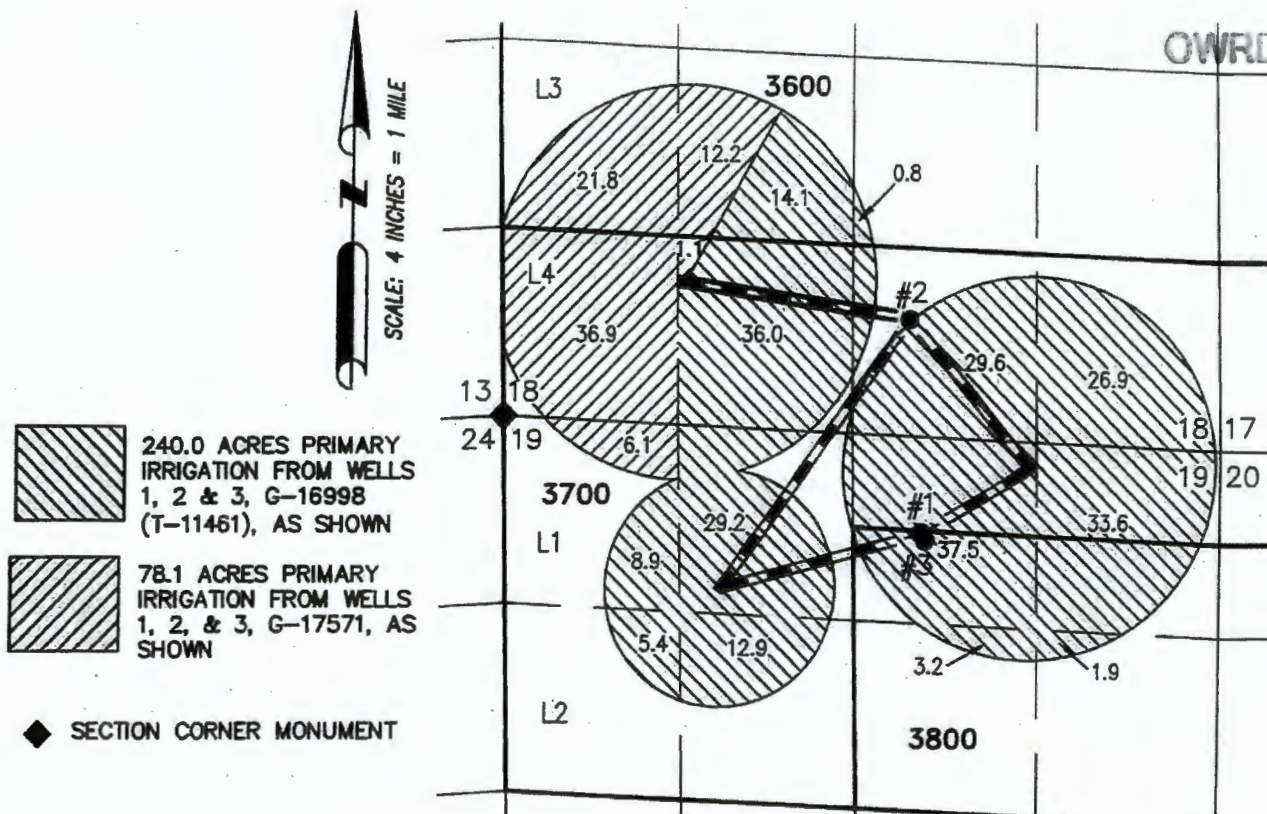

- **#1 (HARN 51409)**
LOCATED 830 FEET SOUTH AND 3033 FEET EAST FROM THE NW CORNER OF SECTION 19. FLOW METER IS 6.0' EAST OF WELL.
- **#2 (HARN 51783)**
LOCATED 1660 FEET NORTH & 2935 FEET EAST FROM THE SW CORNER OF SECTION 18. FLOW METER IS 6.0' EAST OF WELL. NEEDS REPLACEMENT METER INSTALL AT EXISTING SADDLE.
- **#3 (HARN 52646)**
LOCATED 885 FEET SOUTH AND 3060 FEET EAST FROM THE NW CORNER OF SECTION 19. FLOW METER IS 5' NORTH OF WELL.

BURIED 6 OR 8 INCH STEEL PIPE



RENEWAL DATE: 12/31/2022

THIS MAP IS FOR THE PURPOSE OF LOCATING A WATER RIGHT ONLY AND HAS NO INTENT TO PROVIDE LEGAL DIMENSIONS OR THE LOCATION OF PROPERTY LINES.

PREPARED FOR:

JON WARREN
P.O. BOX 491942
REDDING, CA 96049-1942

PREPARED BY:



ALL POINTS ENGINEERING AND SURVEYING, INC.
P.O. BOX 767 TERREBONNE, OR 97760
(541) 548-5833 www.APEandS.com