



Permanent Transfer for Del Strubhar - 2023
Surface Water C 47316 and C 44771 POU

T. 4 S., R. 1 W. W.M.

EXPIRES: 2023.12.31

Legend

FROM Lands

C 47316

C 44771

TO Lands

C 47316


C 44771

Tax lot boundary

C 42319 POU shown for location reference only. Not part of this transfer.



Scale 1" = 1320'

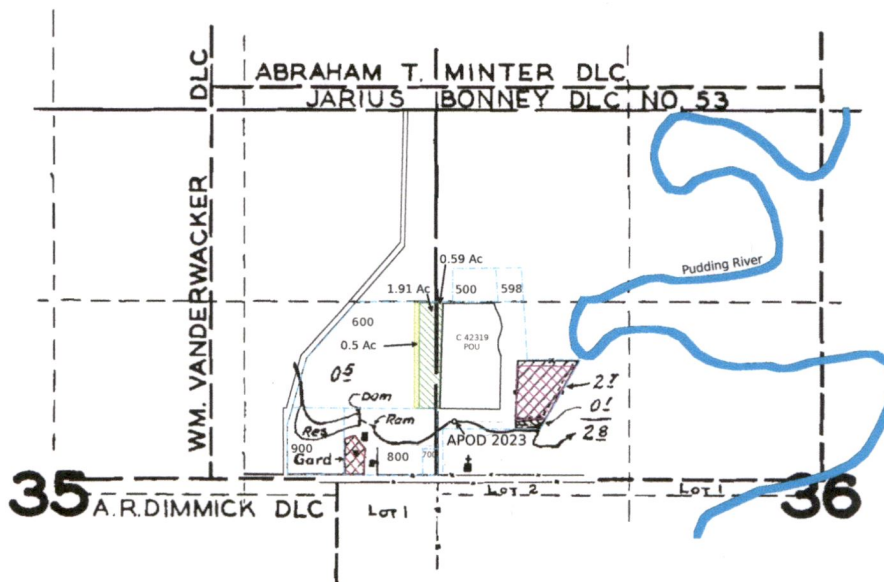

Div: SW1/4 NW1/4, as projected within Bonney DLC 53, Section 36,
T. 4S., R. 1W., W.M., 390 feet North and 1680 feet East from the SW/W Corner, Bonney D:LC 53

FINAL PROOF SURVEY

UNDER

Application No. R-19438 Permit No. R-769
19439 15037

IN NAME OF

C. C. Hepler

Surveyed June 24, 1942, by Geo. D. Naderman


PREPARATION OF THIS MAP IS FOR
THE PURPOSE OF IDENTIFYING THE
LOCATION OF THE WATER RIGHT
ONLY. THERE IS NO INTENT TO
PROVIDE DIMENSIONS OR LOCATION
OF PROPERTY OWNERSHIP LINES.

RECEIVED

APR 18 2023

OWRD

T. 4 S., R. 1 W. W.M.

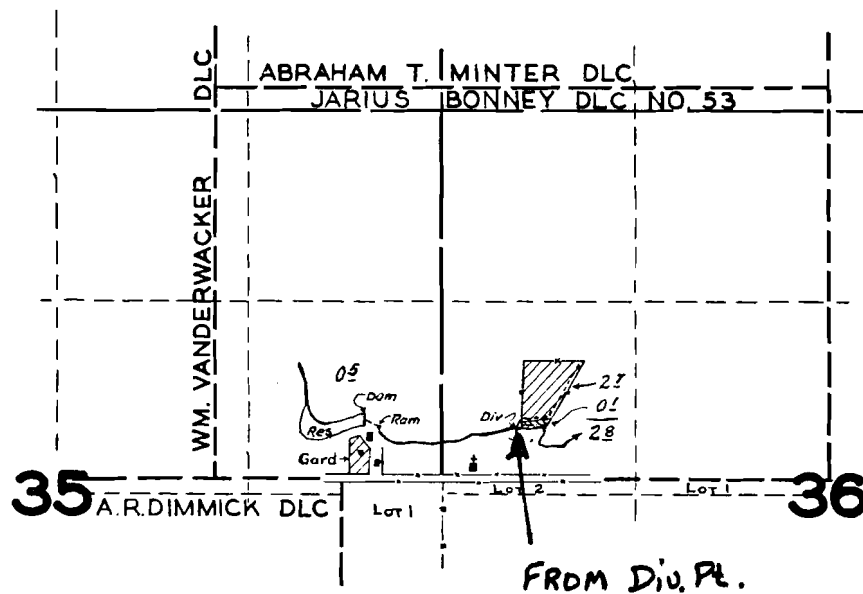

FINAL PROOF SURVEY

UNDER

Application No. R-19438 Permit No. R-769
19439 15037

IN NAME OF

C. C. Hepler

Surveyed June 24, 1942, by Geo. D. Adelman