


D:\admin\Path 9\2024\_Central Point\Source\_Figures\011\_Central Point\Map\_Series\Map\_Series.aprx

**LEGEND**

- Point of Diversion (POD)
- Meter Location
- Conveyance
- Place of Use (POU)
- Government Lot (GL)
- Donation Land Claim (DLC)
- Tax Lot
- Major Road
- Railroad
- Watercourse
- Waterbody

**CERTIFIED WATER RIGHTS EXAMINER STAMP**

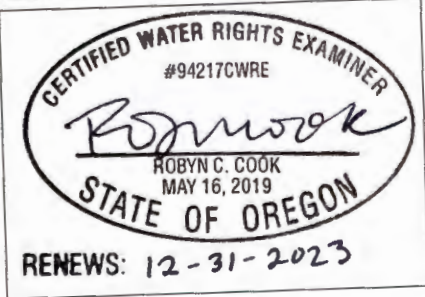

RECEIVED  
 MAR 23 2023  
 OWRD

Claim of Beneficial Use  
 City of Central Point

**T-9900**

Jackson County  
 Township 36, 37 South, Range 2 West (W.M.)

**DISCLAIMER**  
 This map was prepared for the purpose of identifying the location of a water right only and it is not intended to provide legal dimensions or location of property ownership lines.

Date: February 14, 2023  
 Data Sources: BLM, ESRI, OWRD, USGS, Jackson Co.

**LOCATION DESCRIPTION**  
 Duff WTP Intake  
 Located South 25°25'28" East, 4,385.6 feet from the NE corner of Donation Land Claim 42 (W.M.)

