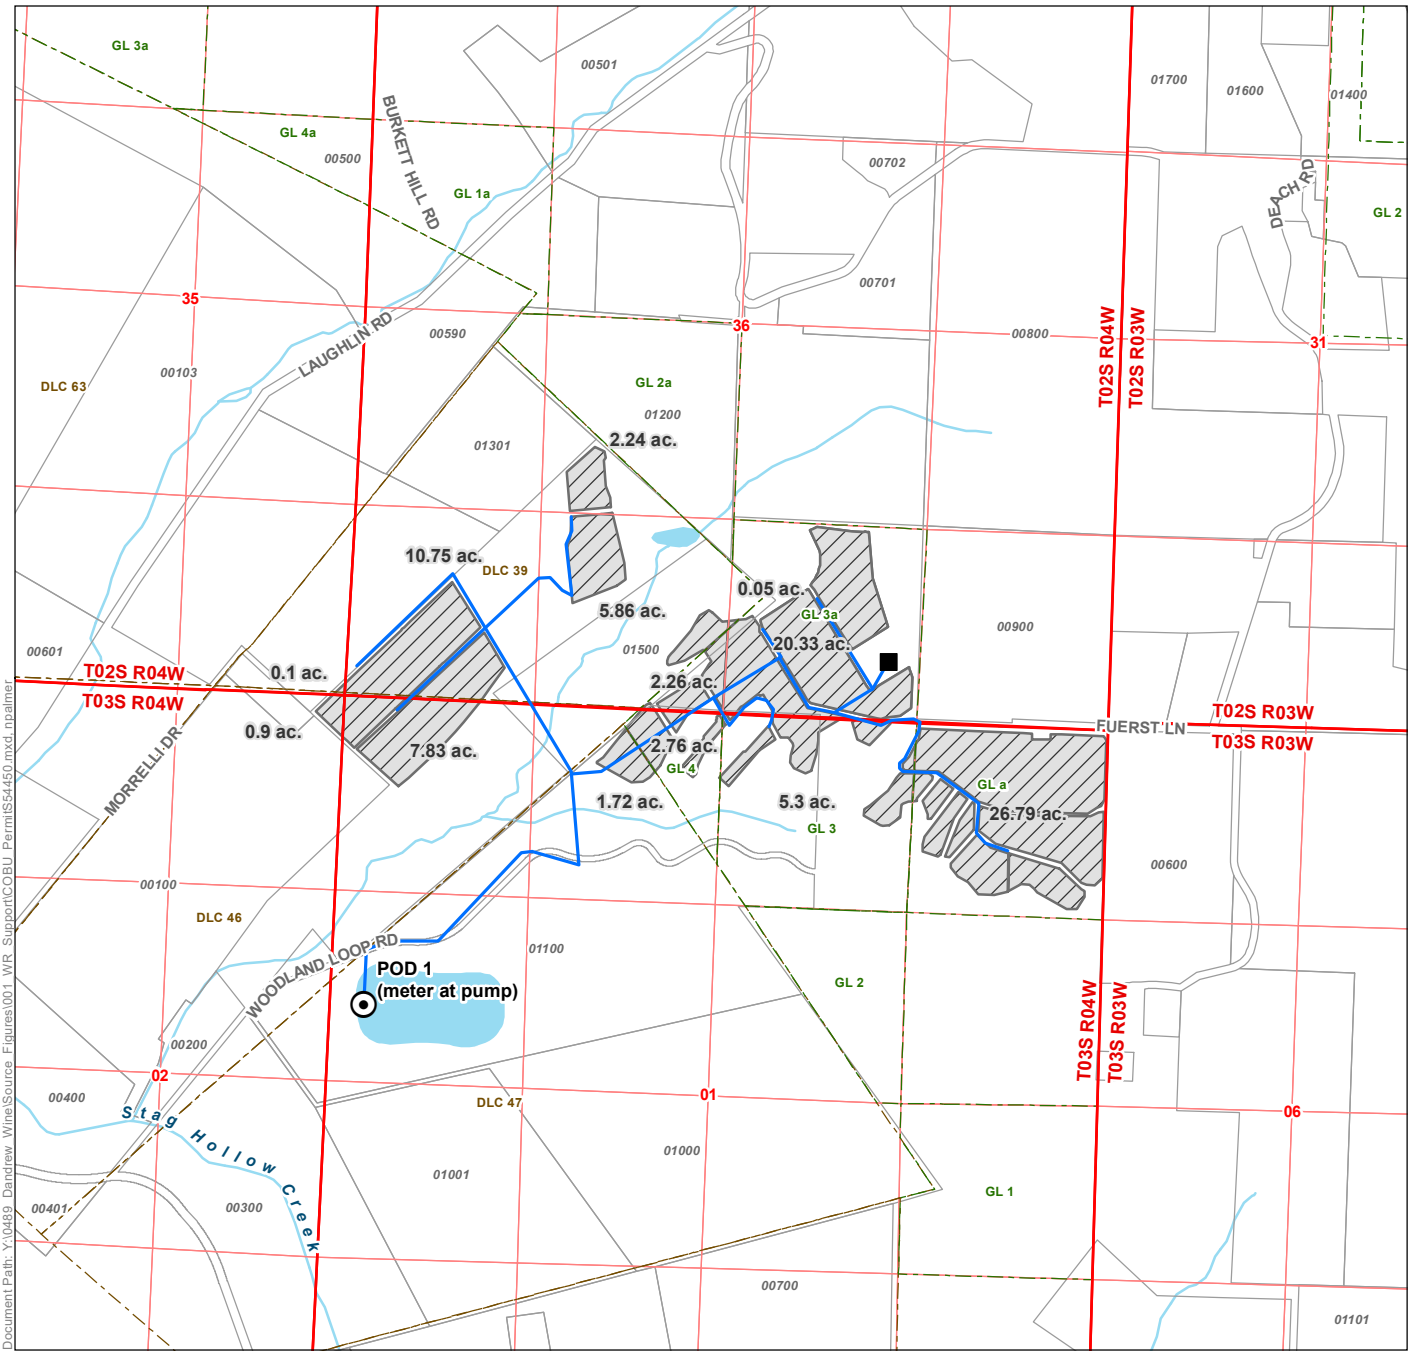

Document Path: Y:\0489_Dandrew_Wine\Source_Figures\001_WR_Support\COBU_Permit\S54450.mxd, npalmer

LEGEND

- Point of Diversion (POD)
- Storage Tanks
- Conveyance Line
- Place of Use (POU)
- Tax Lot
- Donation Land Claim (DLC)
- Government Lot (GL)
- Watercourse
- Waterbody

Claim of Beneficial Use in the name of Dandrew Wine LLC

Application S-86732, Permit S-54450

Township 2, 3 South, Range 4 West (W.M.)

CERTIFIED WATER RIGHTS EXAMINER STAMP

DISCLAIMER

This map was prepared for the purpose of identifying the location of a water right only and it is not intended to provide legal dimensions or location of property ownership lines.

Date: October 30, 2023
Data Sources: BLM, ESRI, OWRD, USGS, Yamhill Co., Maxar Imagery (2021)

LOCATION DESCRIPTION

POD 1
Located 2120 feet South and 483 feet East from the NW corner of Section 1, Township 3 South, Range 4 West (W.M.)

N

0 660 1,320
1 inch = 1,320 feet

GSI Water Solutions, Inc.