


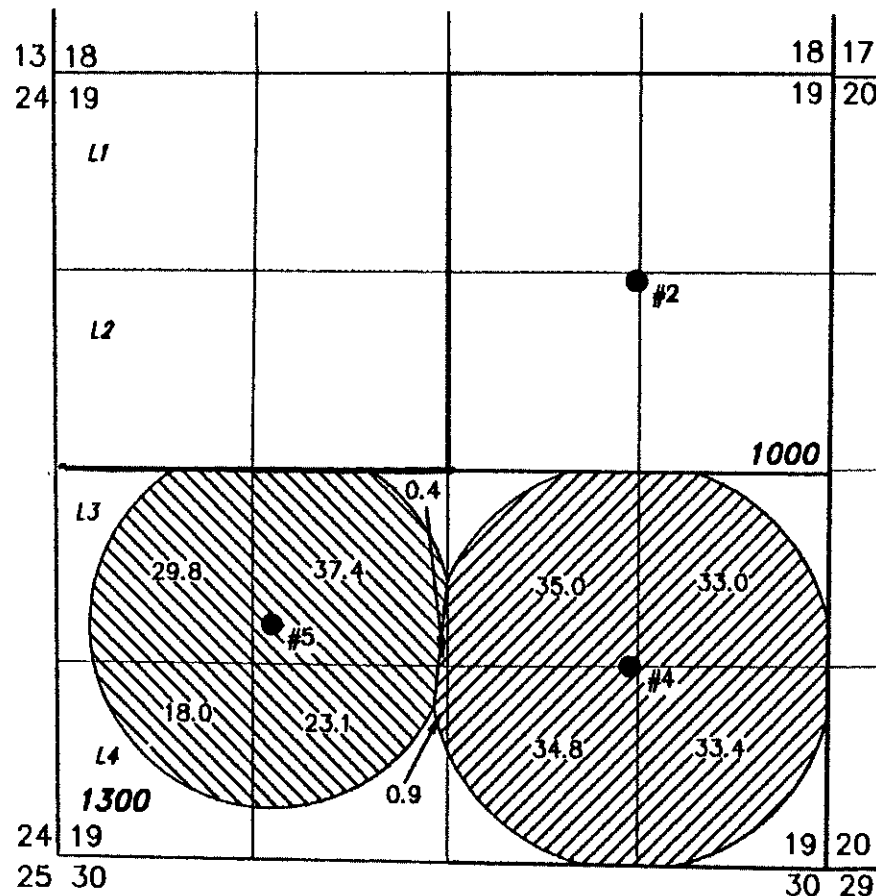

SCALE: 4 INCHES = 1 MILE



FINAL PROOF MAP

TO SHOW PLACES OF USE AND
POINTS OF APPROPRIATION
FOR APPLICATION G-16809
PEILA RANCH, INC.

SECTION 19, TOWNSHIP 27 SOUTH, RANGE 23 EAST, W.M.
TAX LOTS: 1000 & 1300, LAKE COUNTY, OREGON

- **#4 (LAKE 51882) PERMIT: G-16259**
LOCATED IN THE NW 1/4 OF THE SE 1/4 & 1340' NORTH
& 1345' WEST FROM THE SE CORNER OF SECTION 19.
FLOW METER IS 10.5' EAST FROM WELL.
- **#5 (LAKE 51884) PERMIT: G-16259**
LOCATED IN THE NE 1/4 OF THE SW 1/4 & 1420' SOUTH
& 1355' WEST FROM THE NE CORNER OF SECTION 19.
FLOW METER S 11.0' NORTH FROM WELL.

BURIED 8 INCH STEEL PIPE

-  137.5 ACRES PRIMARY IRRIGATION FROM
#4 (G-16259), AS SHOWN
-  108.3 ACRES PRIMARY IRRIGATION FROM
#5 (G-16259), AS SHOWN

RECEIVED BY OWRD

APR 11 2014



RENEWAL DATE: 12/31/2014

THIS MAP IS FOR THE PURPOSE OF LOCATING A WATER
RIGHT ONLY AND HAS NO INTENT TO PROVIDE LEGAL
DIMENSIONS OR THE LOCATION OF PROPERTY LINES

COBU MAP # 822

PREPARED FOR:
PEILA RANCH, INC.
P.O. BOX 897
BURNS, OR 97720

PREPARED BY:



ALL POINTS ENGINEERING AND SURVEYING, INC.
P.O. BOX 767
(541) 548-5833
TERREBONNE, OR 97760
www.APEandS.com