



CLAIM OF BENEFICIAL USE



SE 1/4 - SECTION 11
T. 19 S., R. 12 W., W.M.
LANE COUNTY, OREGON

LOT 1 - BLOCK 2 - LITTLE WOAHINK LAKE SECOND ADDITION

RECEIVED

FEB 17 2021



OWRD

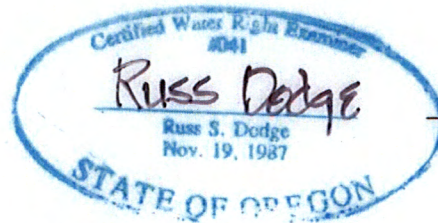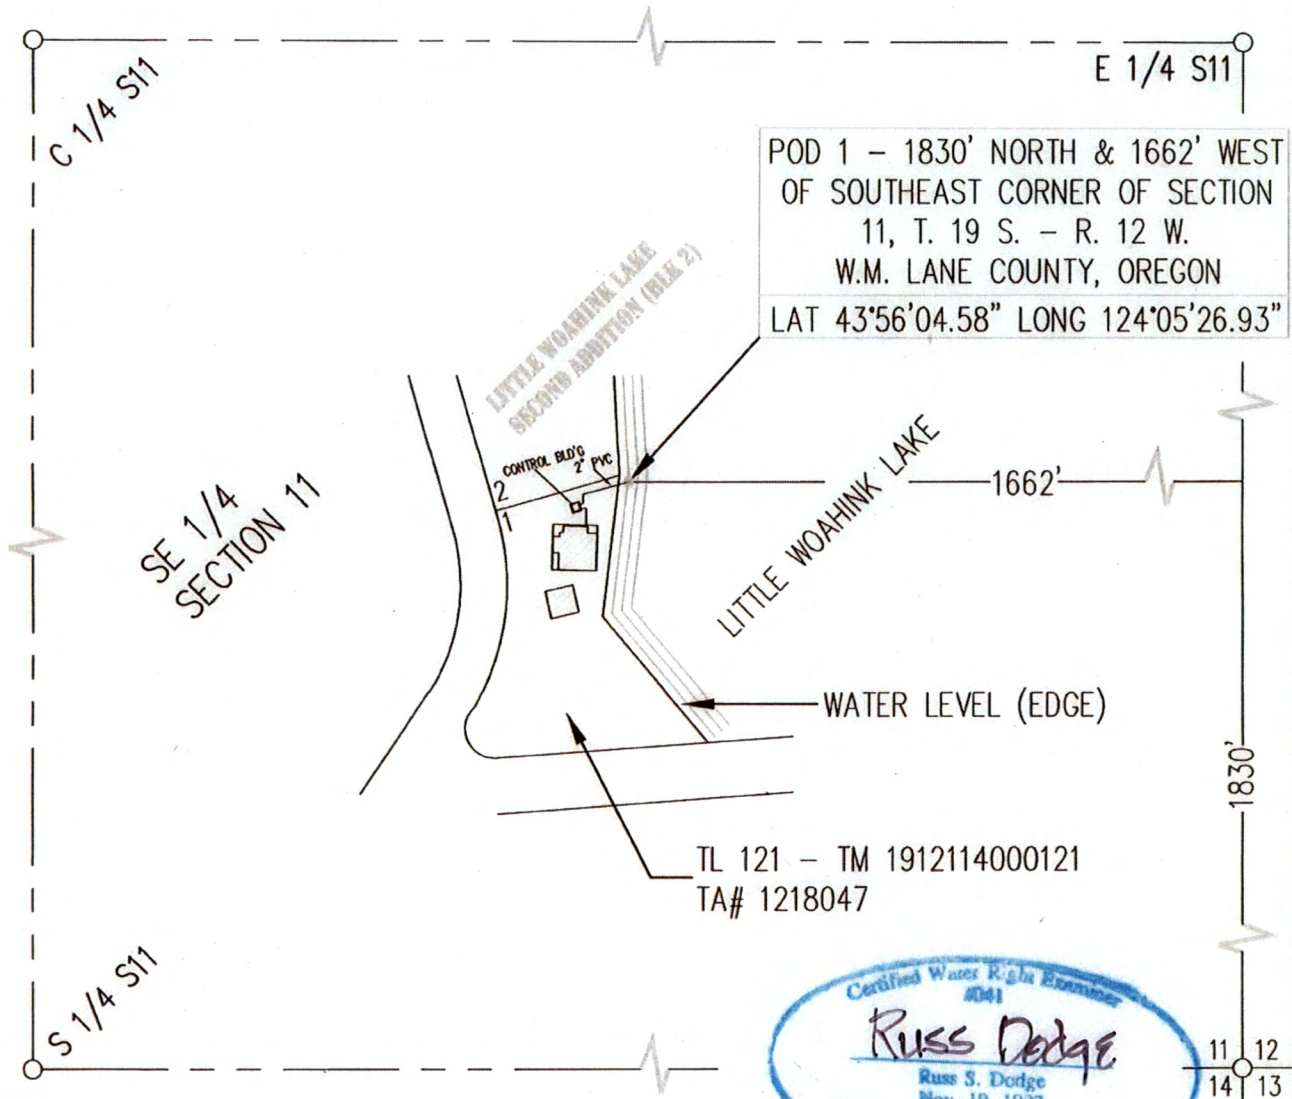

FOR:
MELVIN PANTER
5441 LITTLE WOAHINK DRIVE
FLORENCE, OR. 97439


PREPARED BY:
dodge surveying & planning
656 S. 12TH CT.
COOS BAY, OR. 97420

LEGEND:

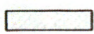-  BUILDINGS
-  POINT OF DIVERSION

OREGON WATER RESOURCES DEPARTMENT
APPLICATION S-85481 PERMIT S-54686
PRIORITY DATE: FEBRUARY 26, 2003

SCALE: 1" = 200'

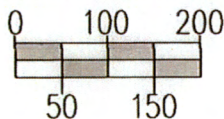

NOTE: THIS MAP WAS PREPARED FOR THE PURPOSE OF IDENTIFYING THE LOCATION OF A WATER RIGHT ONLY AND IS NOT INTENDED TO PROVIDE LEGAL DIMENSIONS OR LOCATION OF PROPERTY OWNERSHIP LINES.

dodge surveying & planning
(541) 404-3799 | rdodge@bge1.com



COOS BAY, OREGON 97420

DATE: FEBRUARY 09, 2021