

CLAIM OF BENEFICIAL USE MAP

APP. # S-87704 PERMIT # S-54795, TAX LOT 200 AND 600, COOS COUNTY,  
LOCATED IN TOWNSHIP 29 SOUTH, RANGE 12 WEST, SECTIONS 27 and 22 W.M.


LEGEND

- P.O.D. #1 & FISH SCREEN
- ⊕ PUMP
- ⊗ PLACE OF USE
- ⊗ FLOW METER
- HOLDING TANKS(2)
- 1.25" PVC Line
- 1" Poly Line


RECEIVED  
AUG 08 2022  
OWRD

Section 22  
Section 27

DISCLAIMER: THIS MAP WAS PREPARED FOR THE  
PURPOSE OF IDENTIFYING THE LOCATION OF WATER  
RIGHT ONLY AND IS NOT INTENDED TO PROVIDE  
LEGAL DESCRIPTIONS OR LOCATIONS OF PROPERTY  
LINES

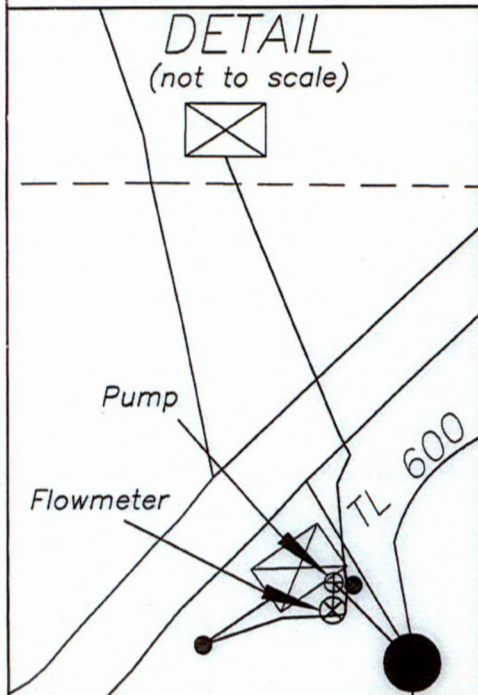

P.O.D. #1  
443 FEET SOUTH &  
239 FEET WEST FROM  
THE NORTH 1/4 CORNER  
OF SECTION 27

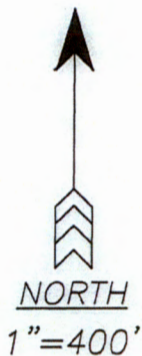

EXPIRES 06/30/2024

NE-NW  
SEC. 27  
QUARTER QUARTER  
SECTION LINES

SE-SW  
SEC. 22

DETAIL

TL 300  
TL 300  
TL 300

MIDDLE FORK

TL 600

TL 101

TL 100

TL 100

ORE. STATE HWY #42

GUERIN LANE

COQUILLE RIVER

NORTH 1/4  
CORNER  
SEC. 27

**VCC**

**VAN CAMP  
CONSULTING**

P.O. Box 995  
Coos Bay, OR 97420  
(541) 297-1880  
vancampconsulting@gmail.com

Prepared For:  
Donald Ryan  
95586 Guerin Lane  
Myrtle Point, OR 97458

Project:  
Claim of Beneficial  
Use Permit S-54795

Date:  
August 1, 2022