


RECEIVED

AUG 25 2014

WATER RESOURCES DEPT
SALEM, OREGON


Final Proof Claim Map For
Application G-7288, Permit G-6715
In the Name of Shine Brothers Ranch, LLC

T. 39 S., R. 19 E., WM
All pertinent lands are within Tax Lot 2400

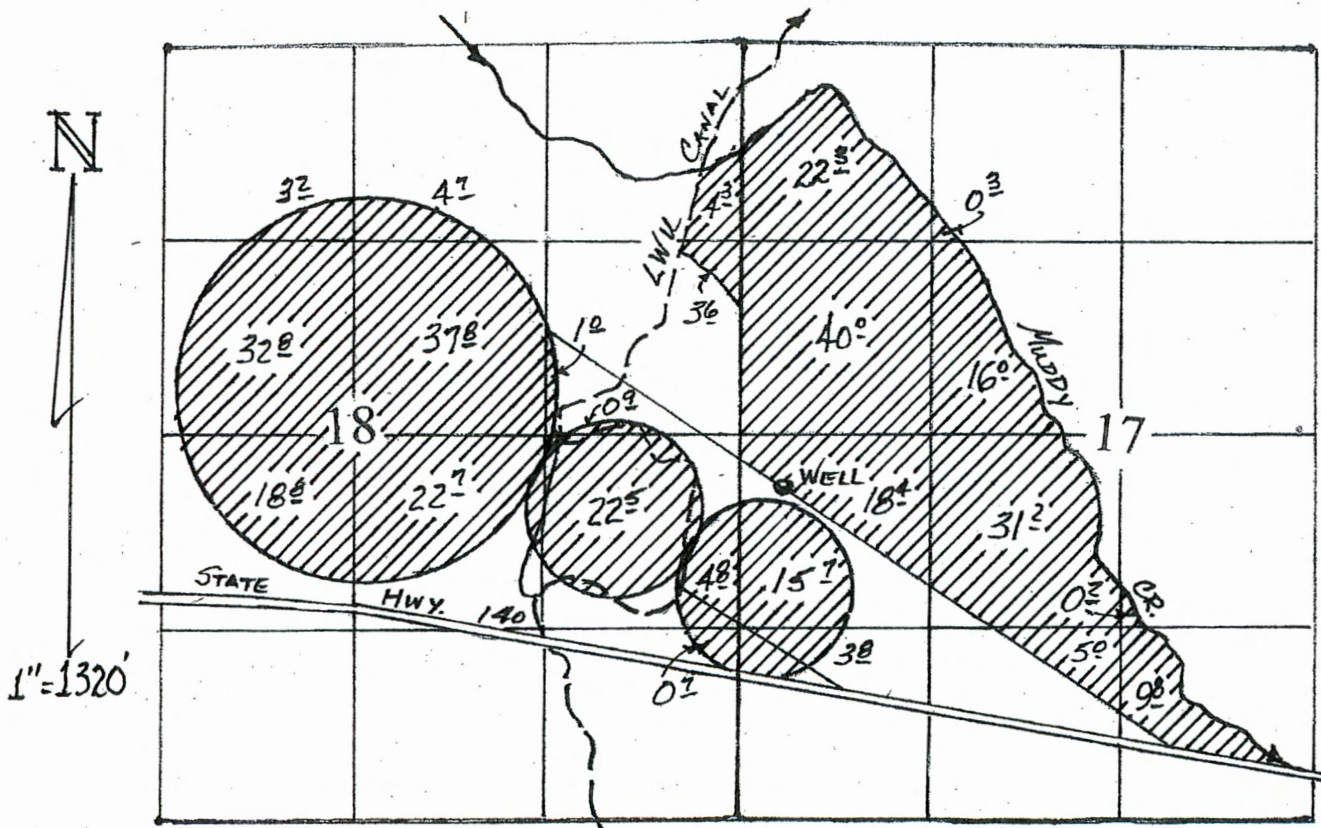

Well Located: 3040' South & 300' East from the NW Corner Section 17.

This map is for the purpose of identifying
The location of water rights only, and is not
Intended to provide legal dimensions or
Locations of property lines.

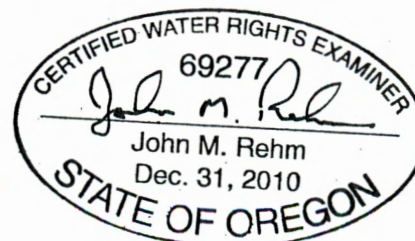

08/14 *AR*