


T6S, R1W, WM
T6S, R2W, WM

MARION COUNTY

TAX LOT:
6 2W 25 00100

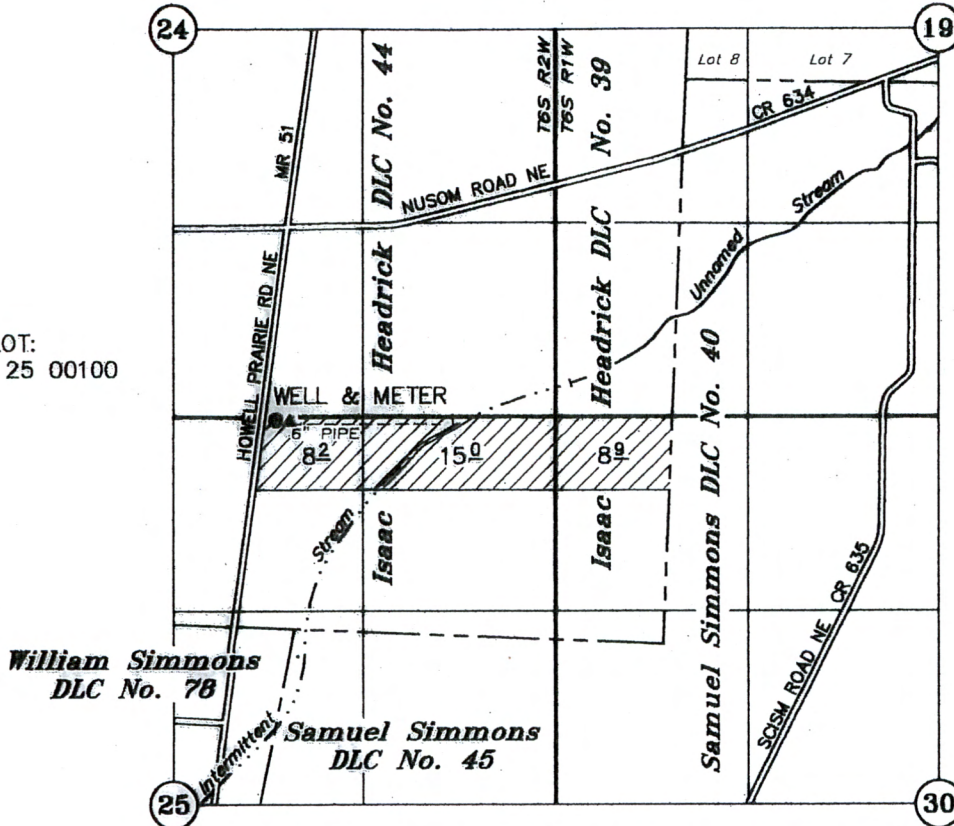

WELL: 15' S AND 1960' W OF THE NE CORNER SECTION 25
METER: 15' S AND 1953' W OF THE NE CORNER SECTION 25

CLAIM OF BENEFICIAL USE

UNDER

Application No. G-16515 Permit No. G-16274

IN THE NAME OF

Norm Wiesner

July 1, 2013


SCALE: 1" = 1320'

RECEIVED

OCT 30 2013

WATER RESOURCES DEPT
SALEM OREGON

NOTE: This map is not intended to provide legal dimensions or locations of property ownership lines.

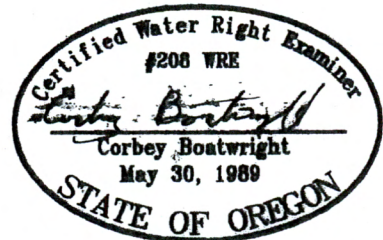

EXPIRES 12-31-13