


T 18S R 42E W.M.

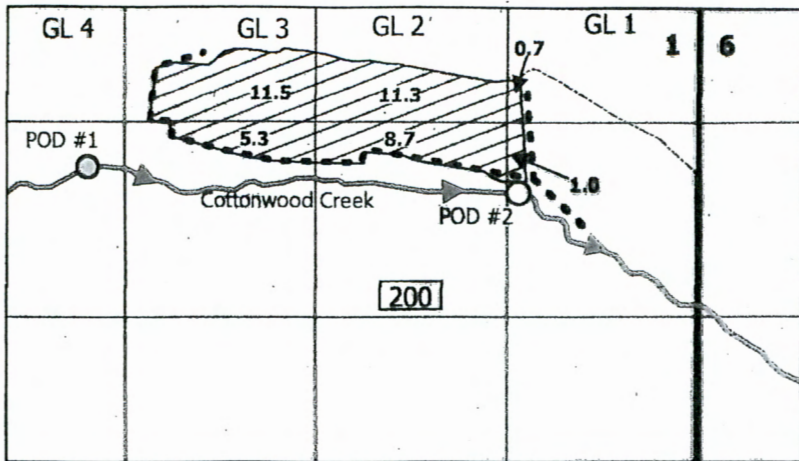


LEGEND

- Cert. 2729 Additional POD
- Cert. 2729 Original POD
- ▨ Cert. 2729 POU
- ▭ Malheur County Taxlot Boundary 200
- 6" Mainline

RECEIVED


DEC 23 1991

WATER

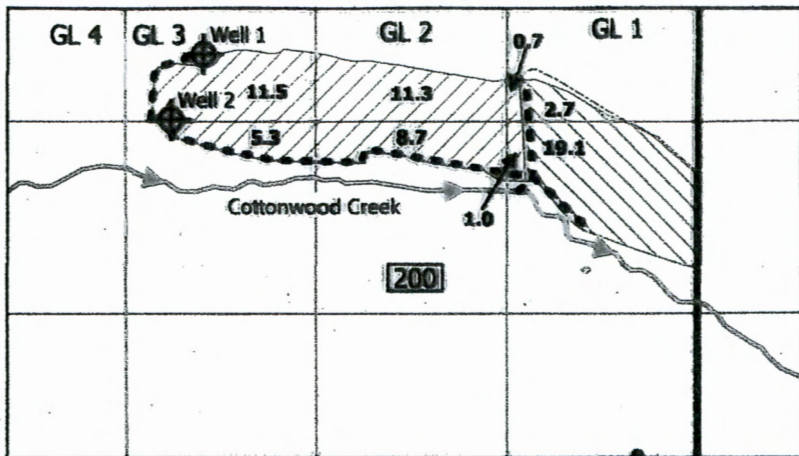

LEGEND

- ⊕ Well
- ▨ Cert. 31186 Supplemental POU
- ▨ Cert. 31186 Primary POU
- ▭ Malheur County Taxlot Boundary 200
- 6" Mainline

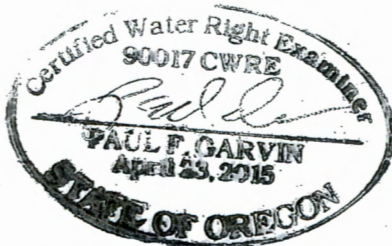

Notes:

This map is not intended to provide legal dimensions or locations of property ownership lines.

Original POD location: 1,600' S and 1,015' E from the NW Corner of Section 1

Additional POD Location: 1,820' S and 1,235' W from the NE Corner of Section 1

Well 1 location: 780' S and 1,875' E from the NW corner of Section 1

Well 2 location: 1,260' S and 1,660' E from the NW corner of Section 1

Flow measurement device located within 10 foot radius of the POD

Fish screens are located within 10 feet of each POD

Garvin
HydroGeo
LLC

Claim of Beneficial Use Map Transfer T-12307 Malheur County, OR

Prepared on behalf of Tom and Linda McElroy

1 inch = 1,320 feet



Drawn by: Paul F. Garvin, RG, CWRE
Date: 12/8/21