


This map is not intended to provide legal dimensions or locations of property ownership lines.

Legend

- T-12630 POU (Cert. 39081 POA change)
- T-12630 POU (Cert. 81575 POD change)
- Mainline
- DLC
- Tax Lot

WILL MCGILL SURVEYING LLC
 15333 Pletzer Rd. SE
 Turner, OR 97392
 503-510-3026
 willmcgillsurveying@gmail.com

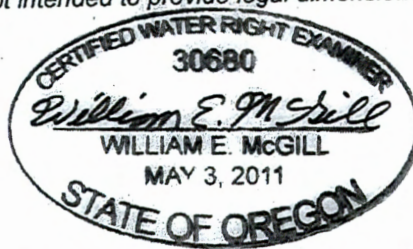

EXPIRES: 12/31/2020