


**T17S R14E, WM
DESCHUTES COUNTY, OR**

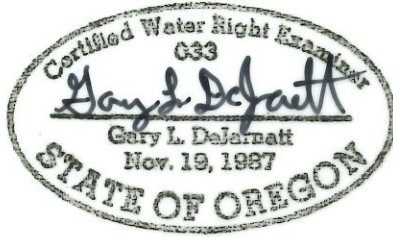


0 400 Feet

1" = 400'

RENEWAL DATE 12/31/2023

- Well & Meter
- Pipeline
- ▨ POU NU
- ⊙ Bulge-in-System
- Section
- Quarter Quarter
- Tax Lot

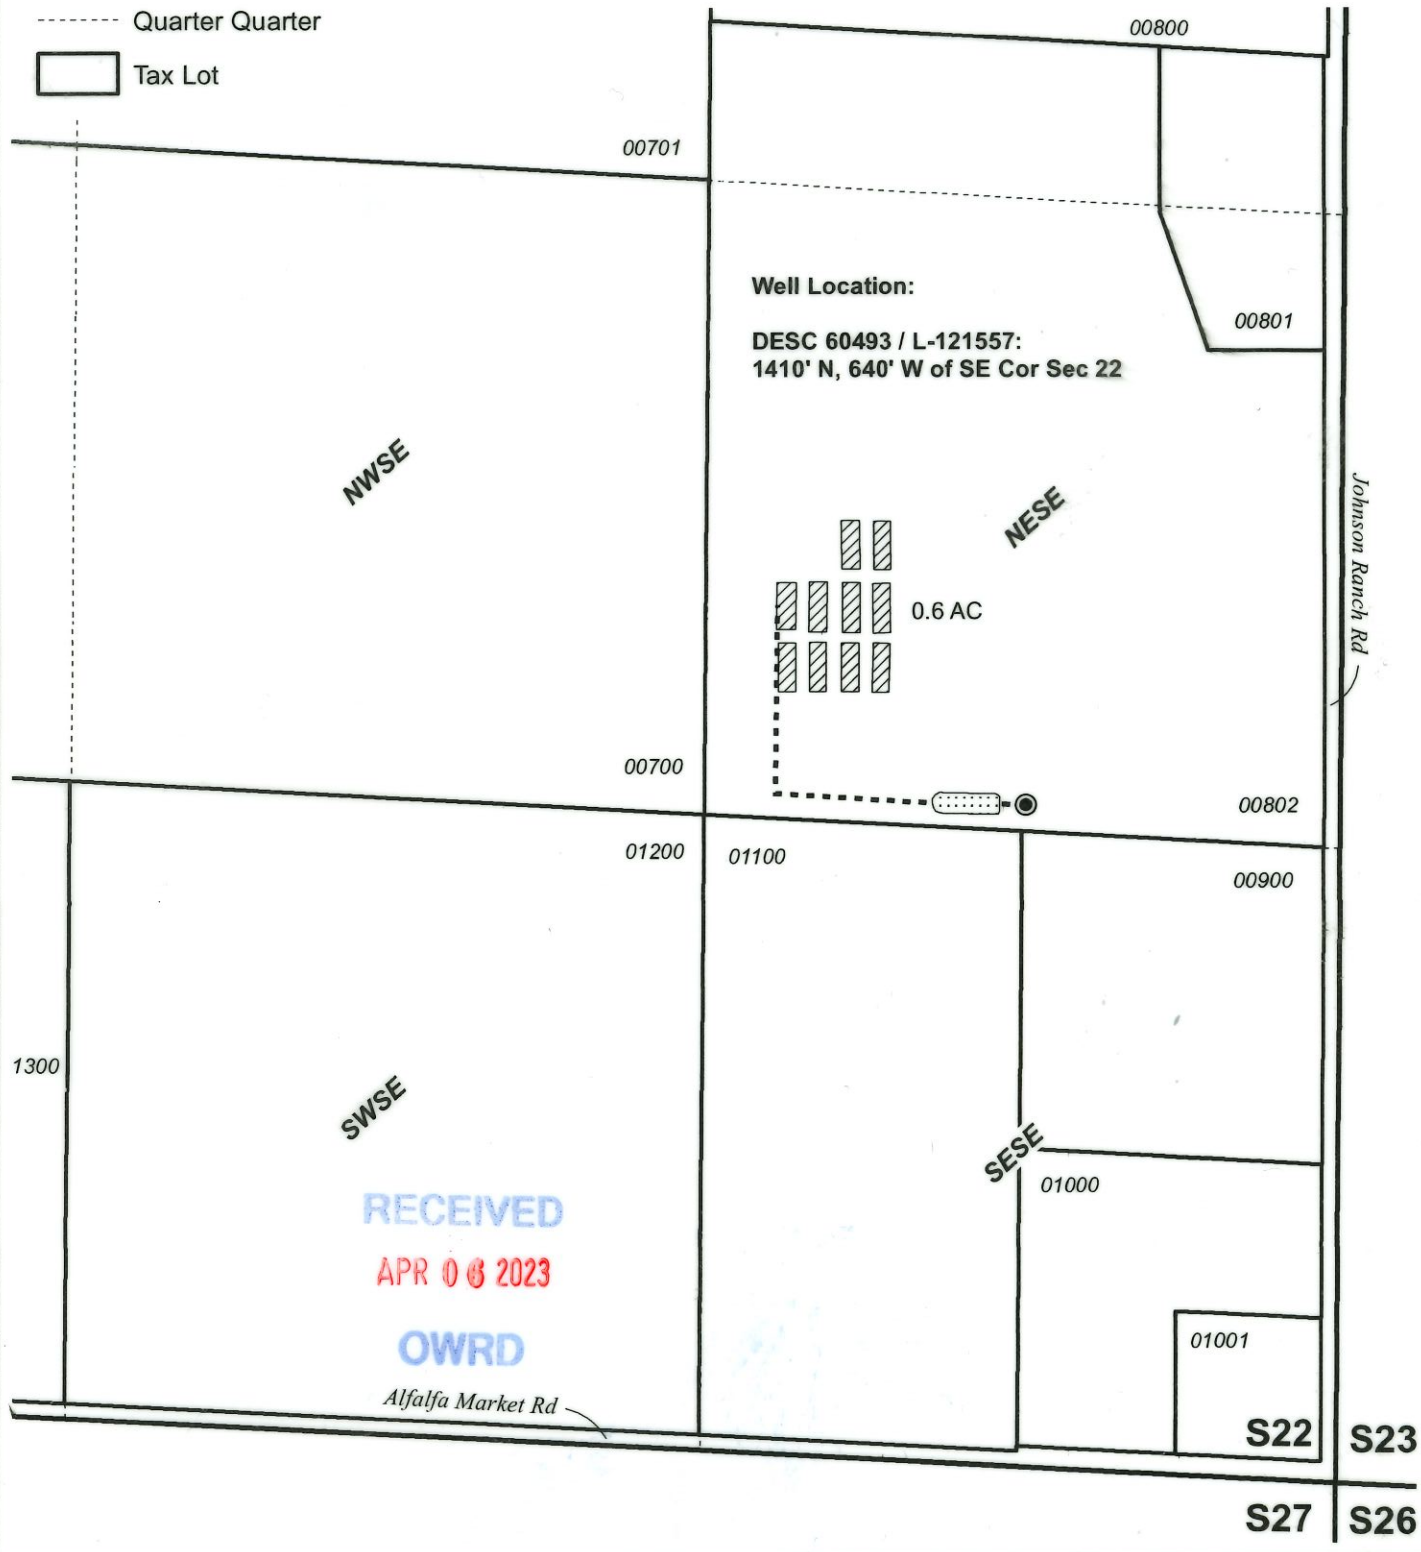

RECEIVED
APR 06 2023
OWRD