


0 660 1,320 2,640 3,960 5,280 Feet


1" = 1320'

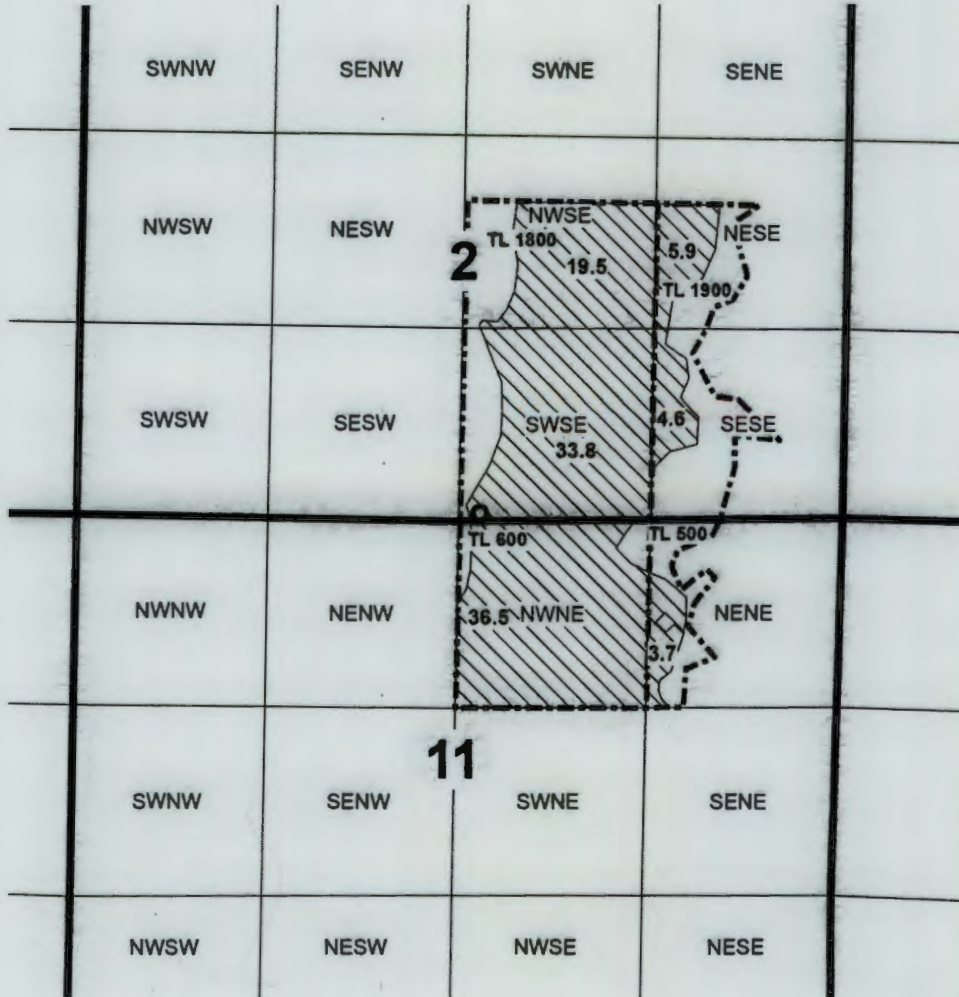

T 23 S, R 9 E, WM SECTIONS 2 & 11 KLAMATH COUNTY, OREGON



WELL W / METER 140' E, 20' N OF S 1/4 CORNER, SECTION 2

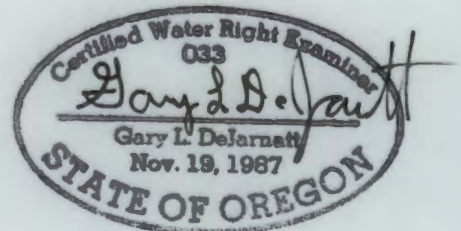


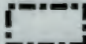

RECEIVED BY OWRD

OCT 25 2013

SALEM, OR

RENEWAL DATE: 12-31-2013

JOB # 13062

- WELL W / METER
-  PLACE OF USE BY QQ
-  TAX LOT BOUNDARIES
-  SECTION LINES

**CLAIM OF BENEFICIAL USE MAP
for PATRICK & KIMBERLY EHLI**

APPLICATION G-13497 PERMIT G-13099

This map is not intended to provide legal dimensions or locations of property ownership lines.

OCT 1, 2013

WATER RIGHT SERVICES, LLC

PO BOX 1830, BEND, OR 97709

WWW.OREGONWATER.US CCB # 197121

541-389-2837

johnshort@usa.com