


T.16S.R.5W.W.M.

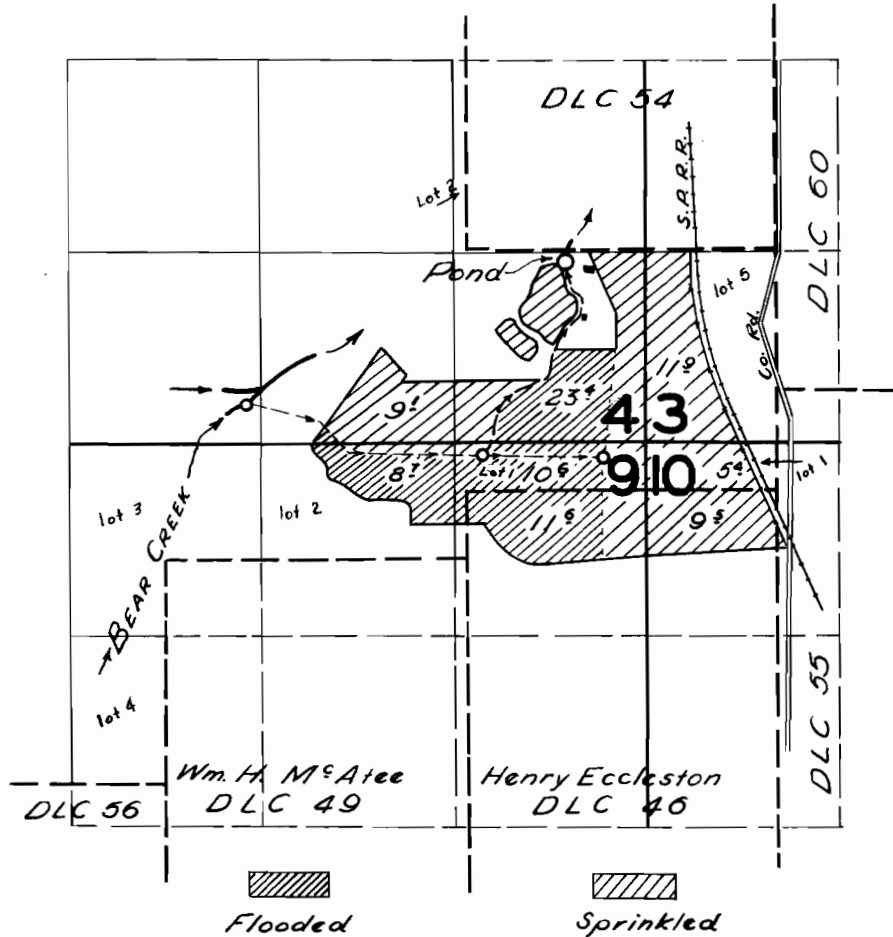

FINAL PROOF SURVEY
UNDER

Application No. 19813 Permit No. 15415


IN NAME OF

J. M. McCORMICK







Surveyed 10 April 1957, by *R. W. Bibby*

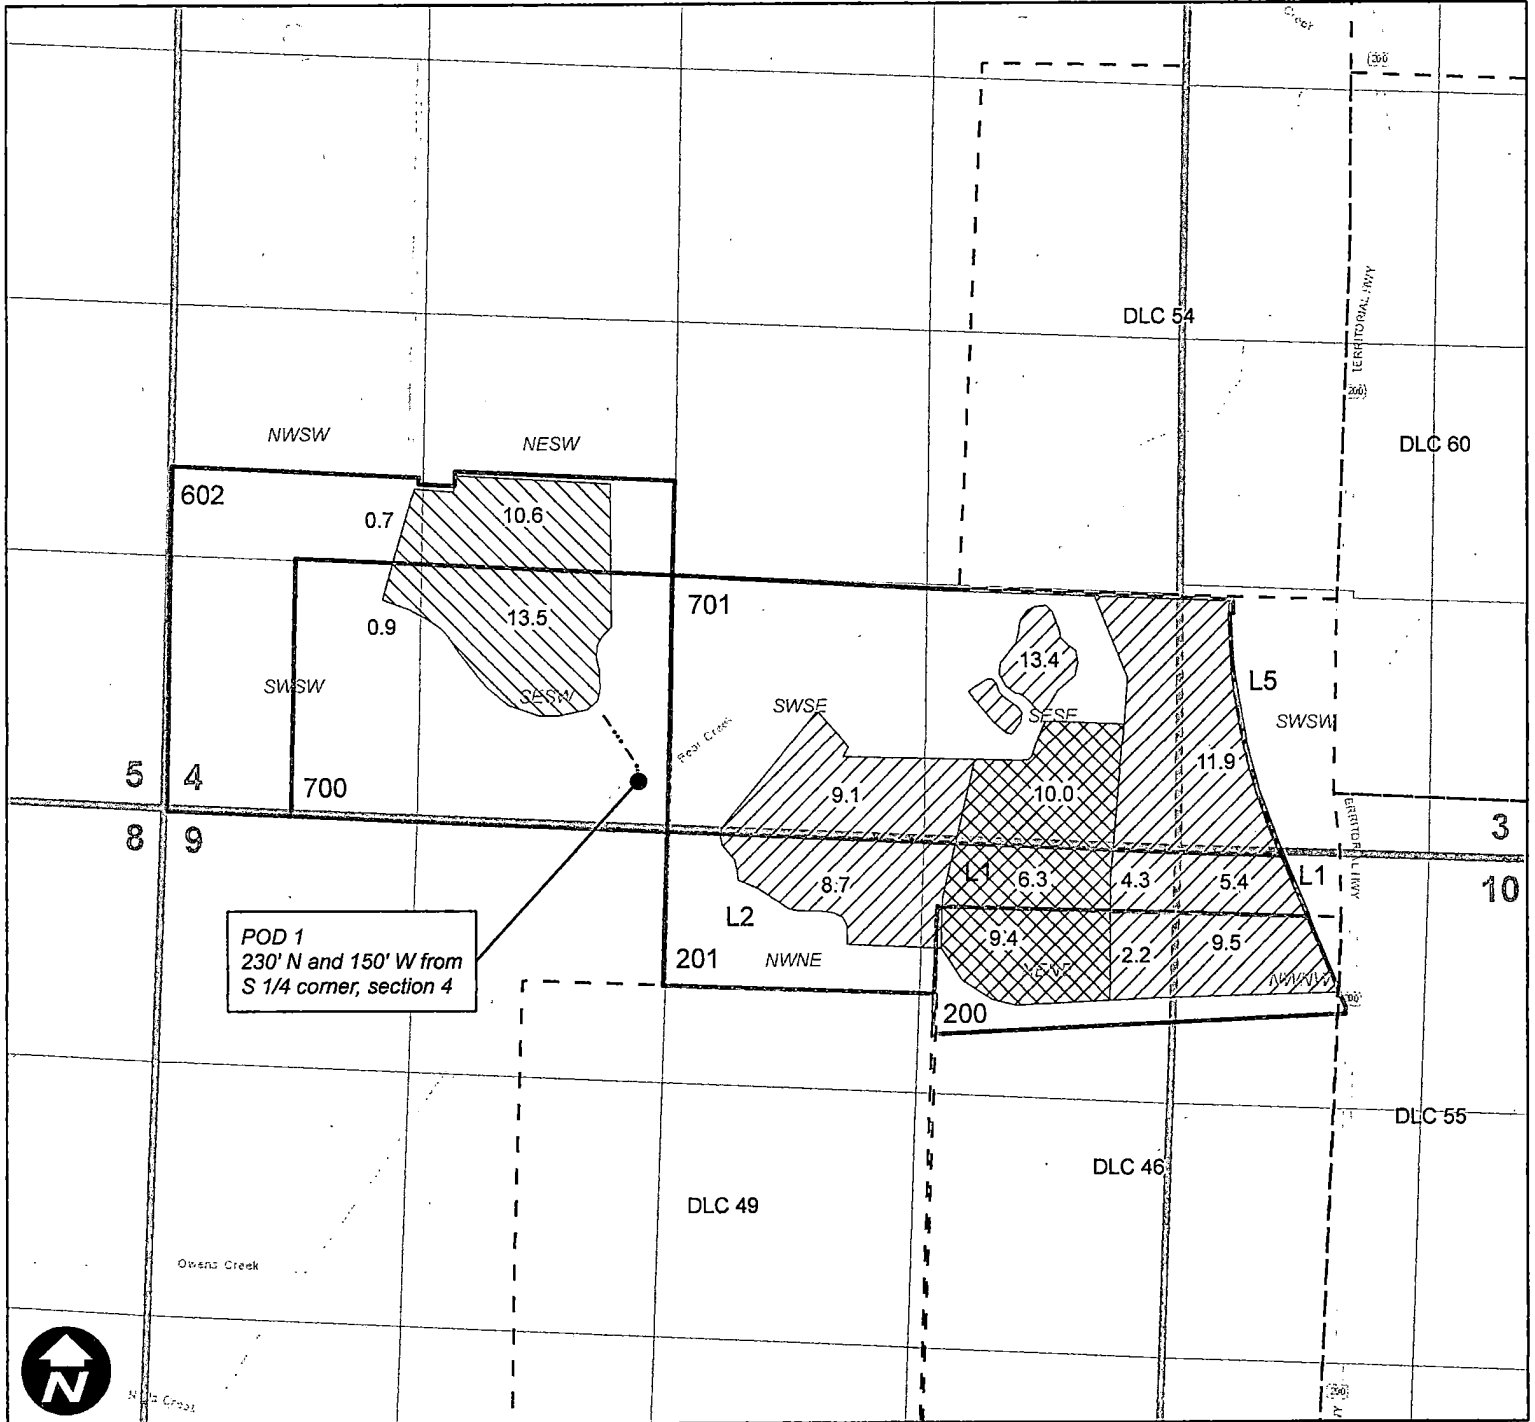Transfer Application - Certificate 23750 Turtle Pond Farm LLC

OWRD
Township 16S, Range 5W, W.M.

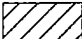 

Legend

-  Cert. 23750 From
-  Cert. 23750 To
-  Cert. 23750 No Change
-  Mainline
-  Taxlot
-  DLC

13832



EXPIRES: 12/31/2022