


Claim of Beneficial Use Map

Application G-13706, Permit G-18361

Drost Land Company LLC

T 40 S, R 11 E, WM
Sections 2 & 3

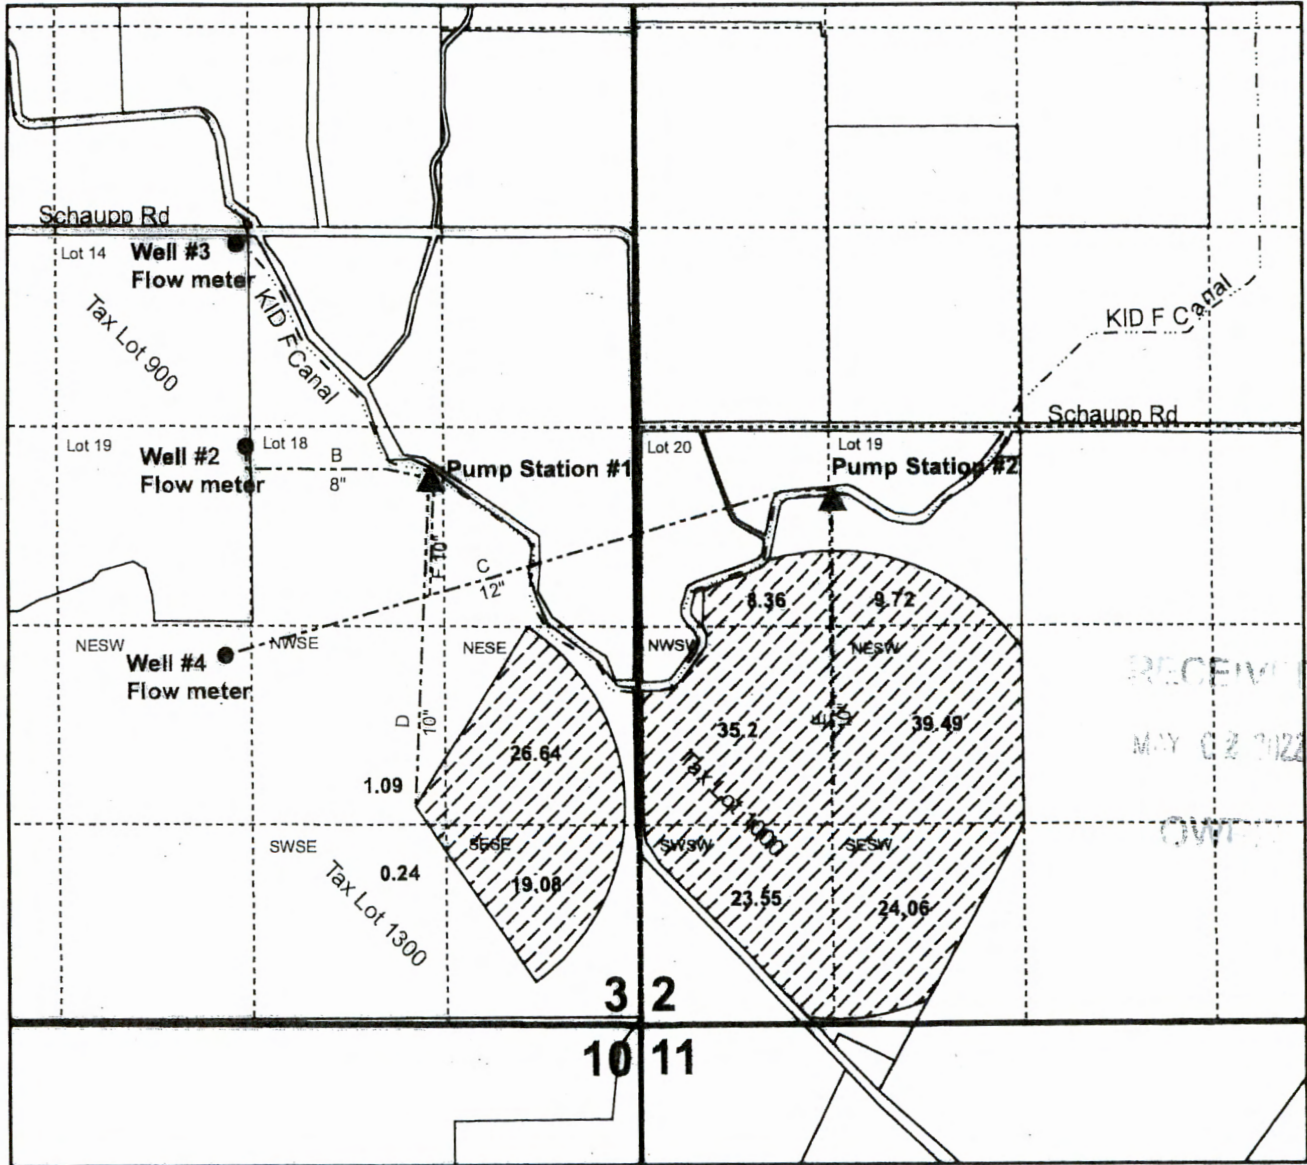

RECEIVED
MAY 02 2022
COUNTY

Legend



- Supplemental 187.43 ac
- Wells used
- Pump station
- Pipeline

Well #2 and Flow meter
3960.4 ft North & 2646.5 ft West
Fm SW Cor. Sec. 2

Well #3 and Flow meter
5328.9 ft North & 2695 Ft West
Fm SW Cor. Sec. 2

Well #4 and Flow meter
2550.5 ft North & 2805 ft West
Fm SW Cor. Sec. 2

All in T 40 S, R 11 E, WM

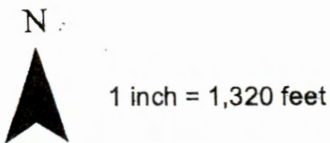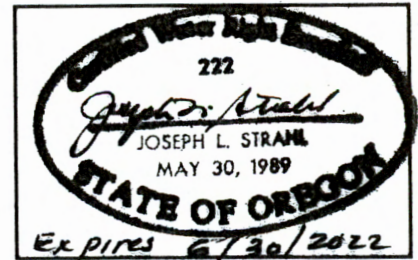

Note: This map is not intended to provide legal dimensions or locations of property ownership lines.