



**Claim of Beneficial Use Map**  
**Application G-16904, Permit G-16970**  
**Dennis Flynn Ranch**

T 35 S, R 20 E, WM  
 Section 25

RECEIVED  
 JUN 15 2020  
 OWRD

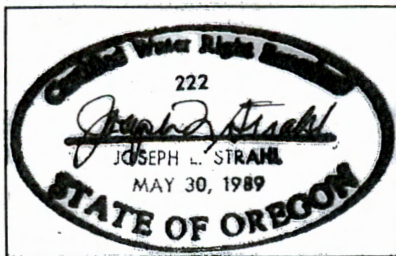

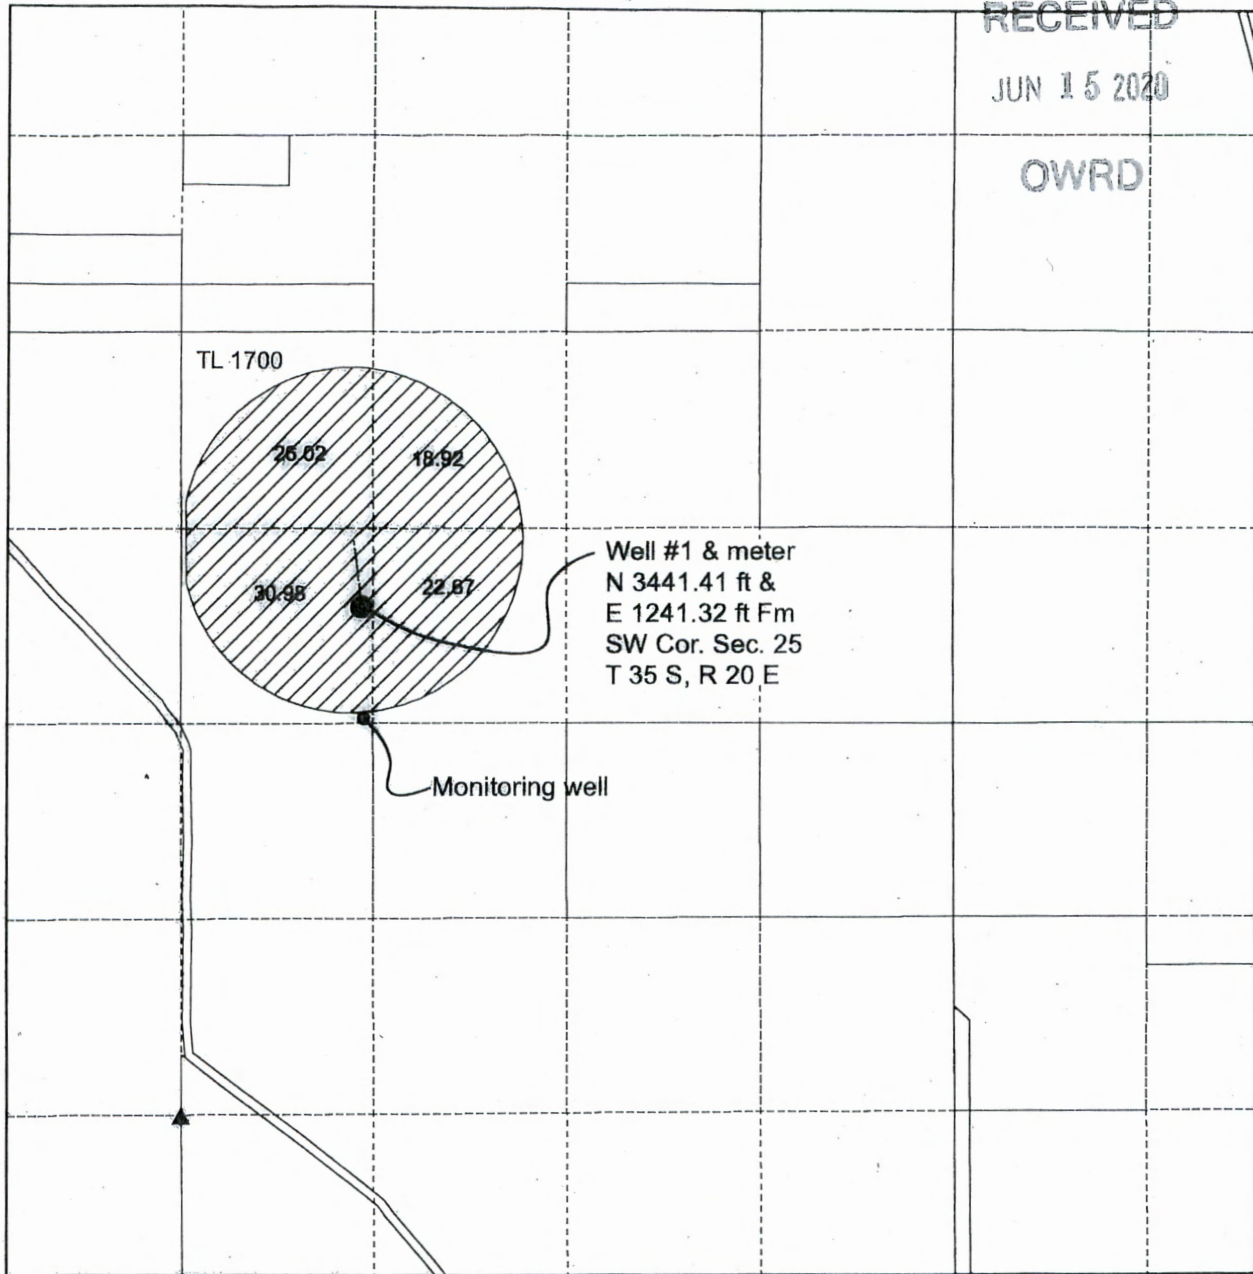




**Note: This map is not intended to provide legal dimensions or locations of property ownership lines.**



**1 inch = 1,320 feet**

**Legend**

-  G-16970 Irrigated
-  Pipeline
-  Well #1 L-110809
-  Obs well
-  Ref Corner