


CLAIM OF BENEFICIAL USE MAP FOR PERMIT G-18526

T 39 S, R 8 W, W M, JOSEPHINE COUNTY

Section 34, SW1/4 SW1/4

July 10, 2022

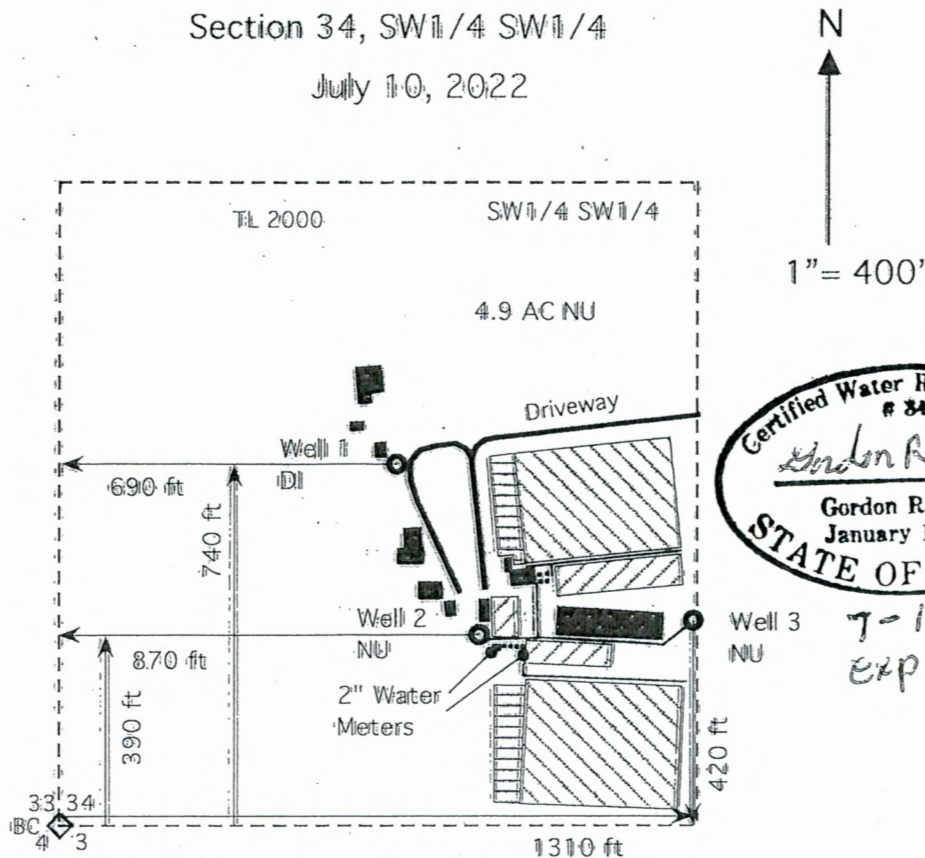

4.9 acres of nursery use rights from well 2 and well 3 under application G-18452, transfer T-13401, and permit G-18526 with a priority of February 6, 2017 at a rate of 0.08 cfs. The crop is recreational cannabis that is fully licensed and legal under the OLCC regulations. All county structural and system permits are filed and approved.

- POA locations. Wells 2 and 3.

Well 1 is JOSE 59737 and L-121750 for exempt domestic use expanded.

Well 2 is JOSE 60035 and L-125227 permitted for nursery use.

Well 3 is JOSE 60625 and L-133525 permitted for nursery use.

- 5000 gallon water tanks (eight).

3.6 acres of drip irrigated outside plants grown in-ground in raised beds. The north field is 1.7 acres and the south field is 1.9 acres.

0.7 acres of water use for greenhouse grown and outside grown containerized nursery plants.

0.6 acres of outside water use for the irrigation of other crops and agricultural purposes.

Buildings

2" and 3" buried PCV pipes.

Tax lot 2000 property lines

This map was drawn by Gordon R. Lyford for Devin Parker to support his claim of beneficial use under water right permit G-18526 for nursery use. Devin Parker owns tax lot 2000.

This map was prepared for the purpose of identifying the location of water rights only and is not intended to provide legal dimensions or the location of property ownership lines.