


**CERTIFIED WATER RIGHT EXAMINER**  
 85503  
 DONN HAMILTON  
 MAY 10, 2012  
**STATE OF OREGON**  
 EXPIRES: June 28, 2012

# T.9S. R.3W. Sec. 14 & 15, W.M.


RECEIVED  
 DEC 20 2021  
 OWRD

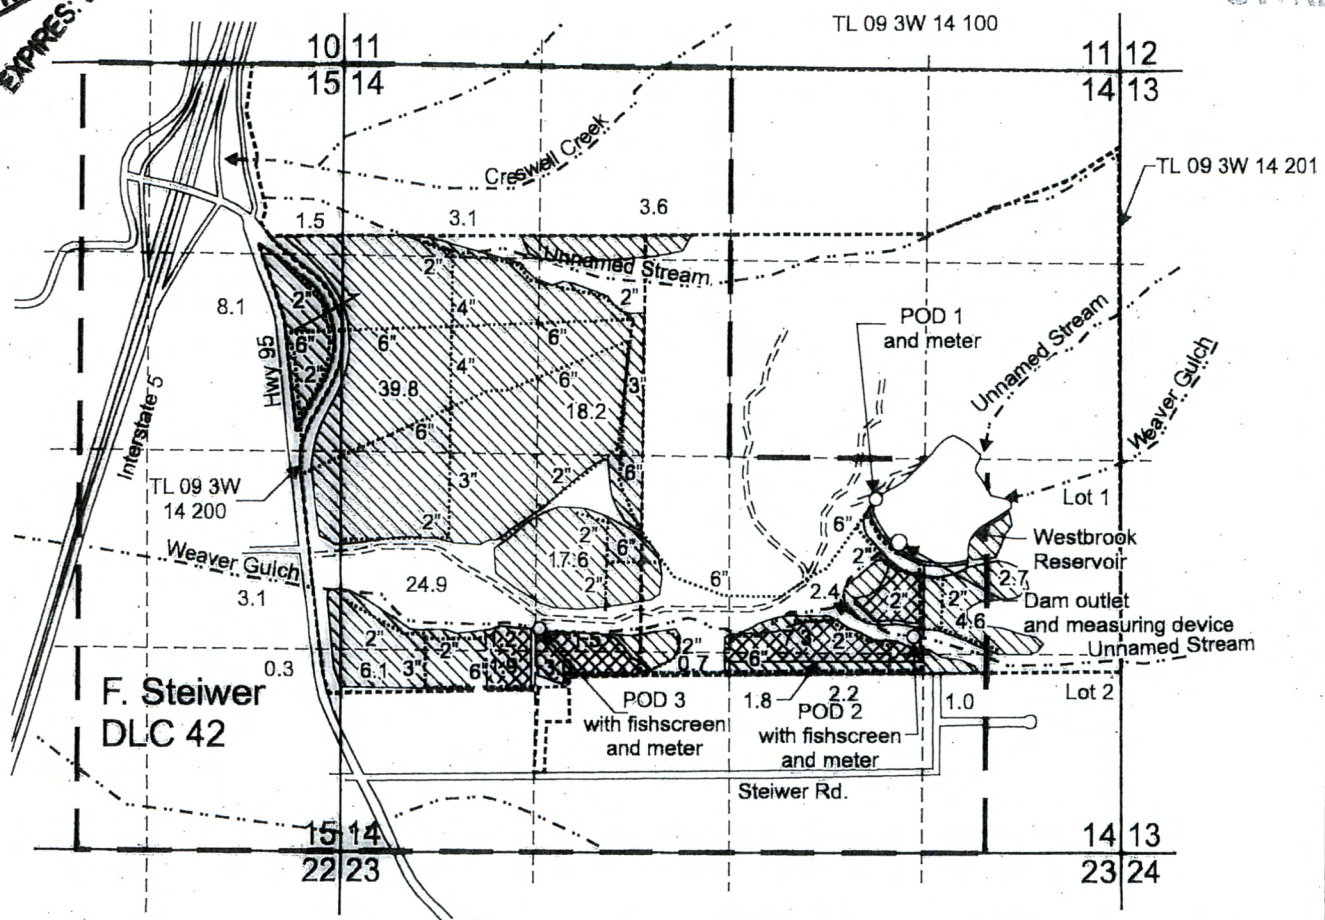

POD 1 (Westbrook Reservoir) is located 2,395 feet north and 1,675 feet west from the SE corner, Section 14.  
 POD 2 (Unnamed Stream) is located 1,460 feet north and 1,410 feet west from the SE corner, Section 14.  
 POD 3 (Weaver Gulch) is located 1,500 feet north and 1,355 feet east from the SW corner, Section 14.

- Area (139.9 Acres) of primary irrigation under Application S-84037, Permit S-53603 irrigated by POD 1, 2, and 3.
- Area (16.7 Acres) of supplemental irrigation under Application S-84037, Permit S-53603 irrigated by POD 1 only, primary water right is Certificate 23305.

----- Tax lot boundary      ——— Donation Land Claim boundary      ..... Water main line

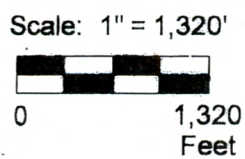

This map was prepared for the purpose of identifying the location of a water right only and is not intended to provide legal dimensions or location of property ownership lines.



Heritage.Jefferson.S-84037COBUMap.cdr

Pacific Hydro-Geology Inc.

**Claim of Beneficial Use Map**  
**Application S-84037, Permit S-53603**

Heritage Seedlings and Liners, Inc.  
 T.9S. R.3W Section 14 & 15, W.M.

11/2021