



COBU MAP # 1276

LEGEND



- POINT OF RE-DIVERSION AND FISH SCREEN (POD 2)
- ⊙ PUMP & METER
-  PLACE OF USE (IRRIGATION) ROGUE RIVER WILDLIFE HABITAT CONSERVATION GROUP LLC
-  PLACE OF USE (IRRIGATION) RICHARD W AND KAREN A BREWSTER REVOCABLE TRUST
- 1/4-1/4 SECTION LINE
- - - - - APPROX. WATERLINE

CLAIM OF BENEFICIAL USE MAP


APPLICATION S-86737, PERMIT S-54384
IRRIGATION

SITUATED IN
SECTION 31 AND 32, TOWNSHIP 34 SOUTH, RANGE 1 WEST, W.M.
JACKSON COUNTY, OREGON

RECEIVED
FEB 08 2021
OWRD

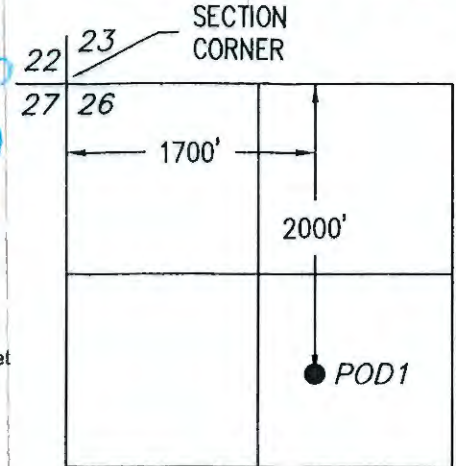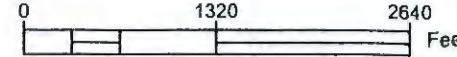

LOST CREEK RESERVOIR
POINT OF DIVERSION
T.33S.,R.1E.,W.M.
SCALE: 1"=1320'

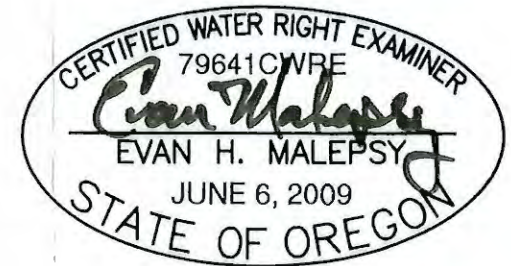

RENEWS: 12/31/2022

This map is not intended to provide legal dimensions or locations of property ownership lines.

EHM—January 26, 2021

ROGUE CIVIL LLC
emalepsy@roguecivil.com 541-621-2868

