COBU MAP # 1277

CLAIM OF BENEFICIAL USE MAP

APPLICATION R-86873, PERMIT R-14674
RESERVOIR
FOR
ROGUE RIVER WILDLIFE HABITAT CONSERVATION GROUP LLC
902 CHEVY WAY
MEDFORD, OR 97504
SITUATED IN
SECTION 31, TOWNSHIP 34 SOUTH, RANGE 1 WEST, W.M.
JACKSON COUNTY, OREGON

N

0 1320 2640 Feet

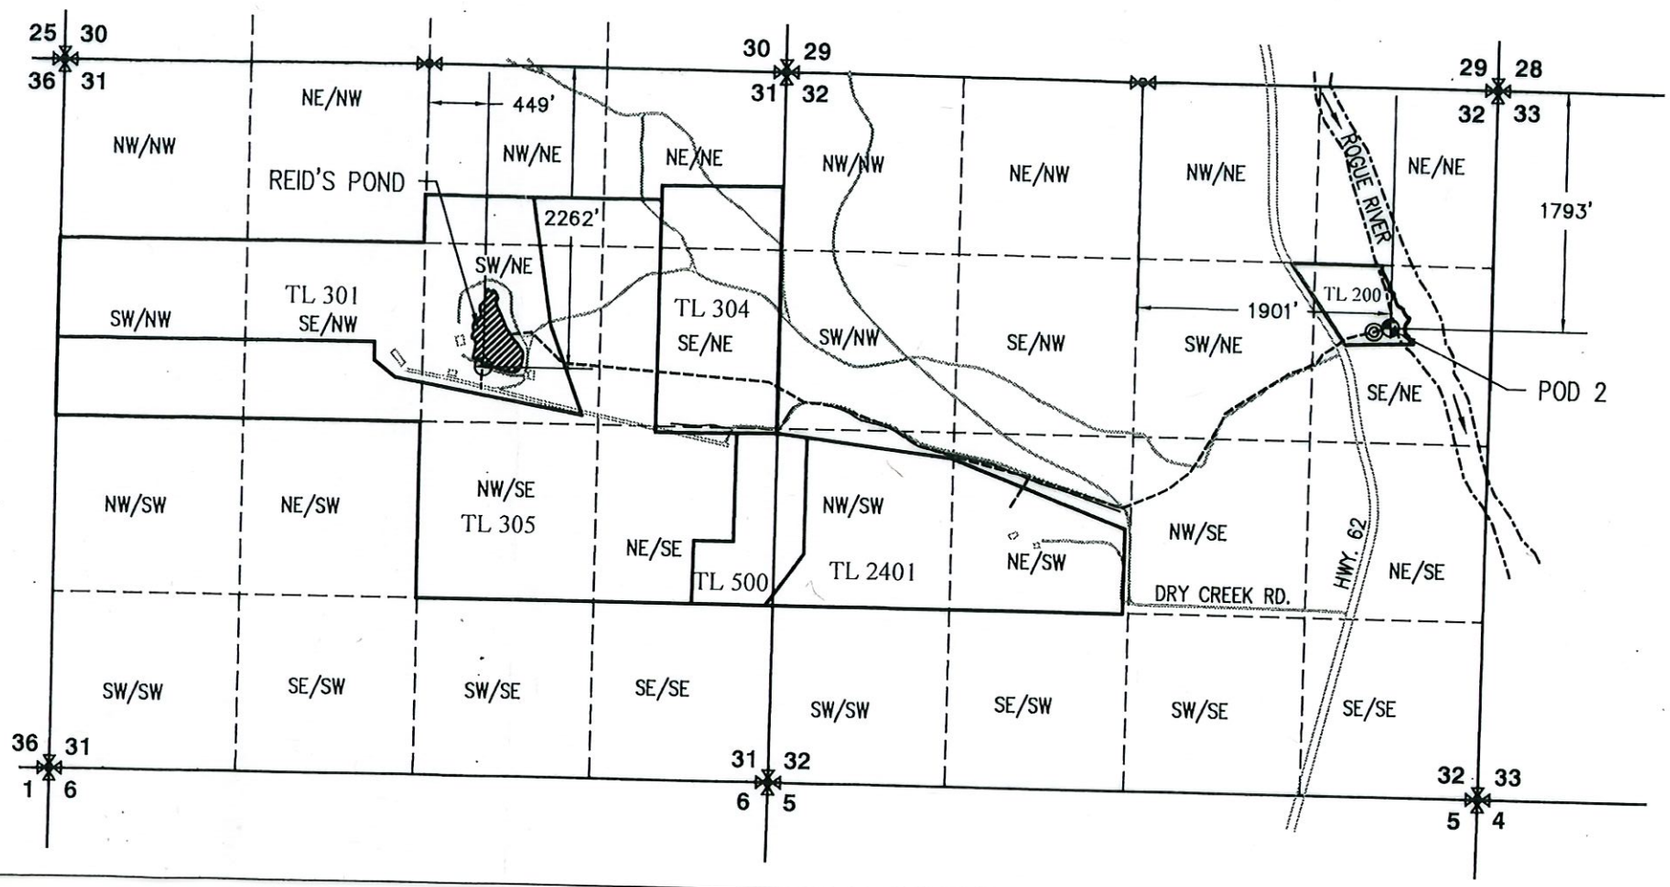

LEGEND

- POINT OF DIVERSION AND FISH SCREEN (POD 2)
- PUMP & METER
- DAM OUTLET LOCATION
- RESERVOIR
- 1/4–1/4 SECTION LINE
- APPROX. WATERLINE

RECEIVED
FEB 08 2021
OWRD

CERTIFIED WATER RIGHT EXAMINER
79641CWRE
EVAN H. MALEPSY
JUNE 6, 2009
STATE OF OREGON

RENEWS: 12/31/2022

This map is not intended to provide legal dimensions or locations of property ownership lines.

EHM–January 26, 2021

ROGUE CIVIL LLC
emalepsy@roguecivil.com 541-621-2868