


Sections 7, 8 & 9, T6S, R20E, W.M.  
Wheeler County

CLAIM OF BENEFICIAL USE MAP  
Transfer T-11670  
Stanley Ranch LLC

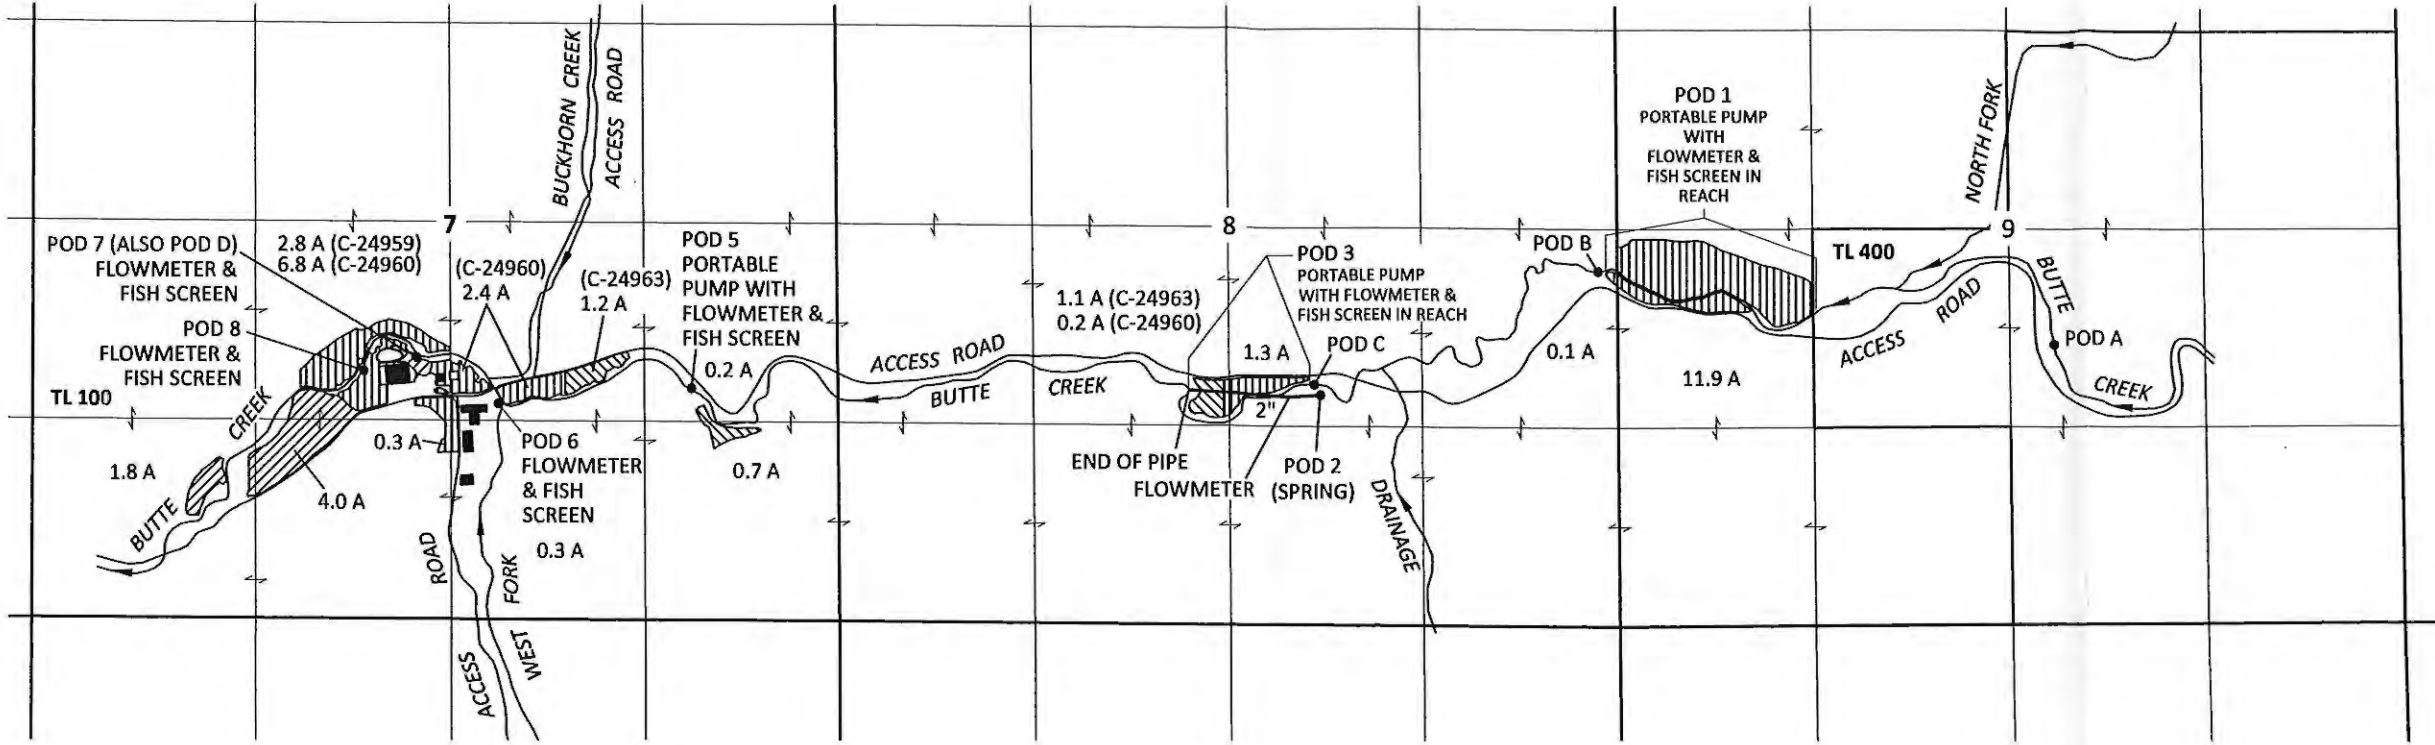


RECEIVED  
MAY 26 2021  
OWRD

- POD 1 LOCATION: 2150 FT N AND 1350 FT E EXTENDING TO 2440 FT N AND 100 FT W FROM SE CORNER SECTION 8, T6S, R20E, W.M.  
POD 2 LOCATION: 1590 FT N AND 2060 FT W FROM SE CORNER SECTION 8, T6S, R20E, W.M.  
POD 3 LOCATION: 1660 FT N AND 2130 FT W EXTENDING TO 1630 FT N AND 2970 FT W FROM SE CORNER SECTION 8, T6S, R20E, W.M.  
POD 5 LOCATION: 1590 FT N AND 1020 FT W FROM SE CORNER SECTION 7, T6S, R20E, W.M.  
POD 6 LOCATION: 1490 FT N AND 2350 FT W FROM SE CORNER SECTION 7, T6S, R20E, W.M.  
POD 7 LOCATION: 1780 FT N AND 2650 FT E FROM SW CORNER SECTION 7, T6S, R20E, W.M.  
POD 8 LOCATION: 1690 FT N AND 2290 FT E FROM SW CORNER SECTION 7, T6S, R20E, W.M.  
POD A LOCATION: 1940 FT N AND 2980 FT E FROM SW CORNER SECTION 9, T6S, R20E, W.M.  
POD B LOCATION: 2430 FT N AND 150 FT W FROM SE CORNER SECTION 8, T6S, R20E, W.M.  
POD C LOCATION: 1660 FT N AND 2100 FT W FROM SE CORNER SECTION 8, T6S, R20E, W.M.  
POD D LOCATION: 1780 FT N AND 2650 FT E FROM SW CORNER SECTION 7, T6S, R20E, W.M.

EXPLANATION

- PLACE OF USE - CERTIFICATE 24959 IRRIGATION - 8.6 ACRES PRIORITY DATE: 1880  
PLACE OF USE - CERTIFICATE 24960 IRRIGATION - 23.3 ACRES PRIORITY DATE: 1886  
PLACE OF USE - CERTIFICATE 24963 IRRIGATION - 3.2 ACRES PRIORITY DATE: 1895  
POINT OF DIVERSION (POD)  
BURIED PIPE (APPROX.)

Site Inspections Conducted:  
June 6, 2018,  
August 9, 2020 &  
April 21, 2021

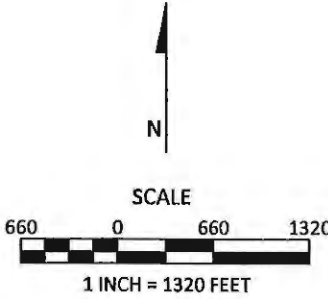

May 13, 2021

This map is not intended to provide legal dimensions or locations of property ownership lines

Figure 1



SKOOKUM  
WATER ASSOCIATES INC

1626 VICTORIAN WAY  
EUGENE, OR 97401  
(503) 319-8926

KPFF 1700014.84

Note: The POD locations are redescribed from the Transfer T-11670 application map because updated U.S. Bureau of Land Management survey data was used.