

CLAIM OF BENEFICIAL USE MAP

FOR: GORDON FLEIG
 BY: NATHAN REED, PE, CWRE
 T24S, R7W, W.M. SECTION 11, GLOT 2
 APPLICATION NO. S-88100
 PERMIT NO. S-54965

DATE SURVEYED: JANUARY 5, 2021



SCALE: 1" = 400'


RECEIVED

JAN 23 2021

OWRD

Legend

- Stream
- POD
- Pipeline
- Meter
- Structure
- Flow arrow
- Gov Lot
- Meander
- Quarter
- Sixteenth
- Parcels

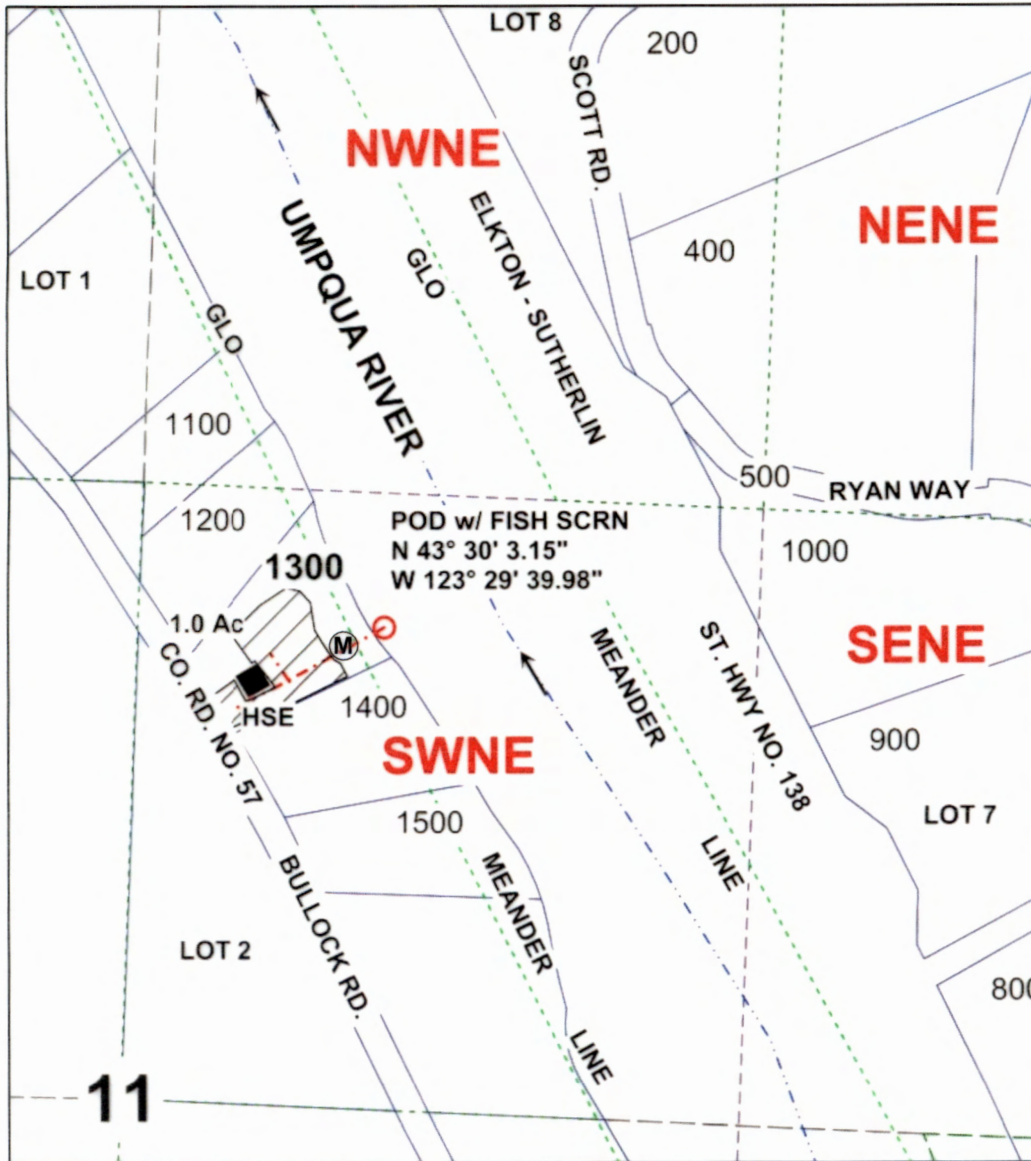

POD IS LOCATED 1580 FEET SOUTH AND 2240 FEET WEST FROM THE NE CORNER, SECTION 11 AS PROJECTED IN GOVERNMENT LOT 2.

MAP PREPARED FOR:
 GORDON FLEIG
 2007 BULLOCK RD
 OAKLAND, OR 97462



THE PURPOSE OF THIS MAP IS TO IDENTIFY THE LOCATION OF THE WATER RIGHT. IT IS NOT INTENDED TO PROVIDE INFORMATION RELATIVE TO THE LOCATION OF PROPERTY OWNERSHIP BOUNDARY LINES.

MAP PREPARED BY:
 NATHAN R. REED, PE, CWRE
 157 WEST BODIE STREET
 ROSEBURG, OR 97471