



Claim of Beneficial Use - Roscoe Divine LLC
 Application G-17726, Permit G-17162

Township 17S, Range 4W, W.M.

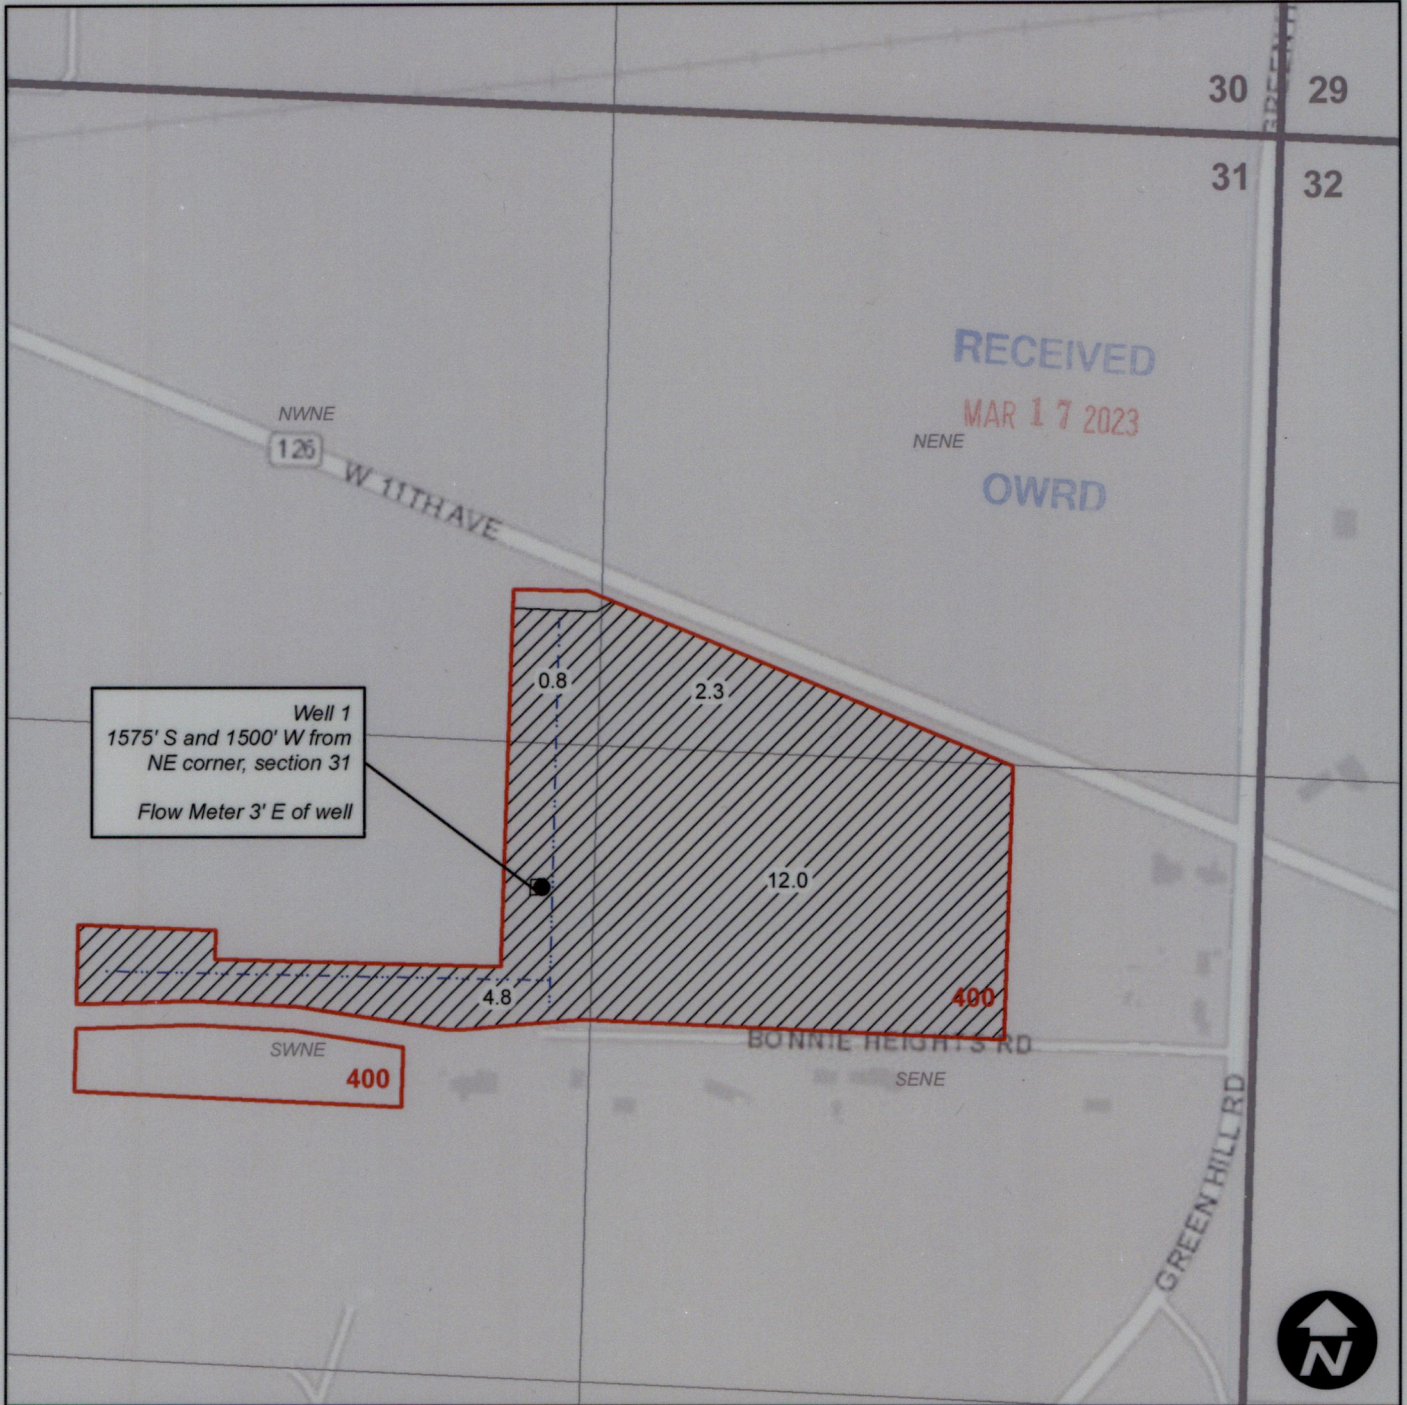


This map is not intended to provide legal dimensions or locations of property ownership lines.

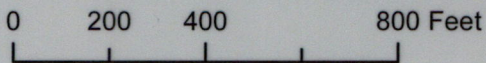

Legend

- POU
- Mainline
- Tax Lot

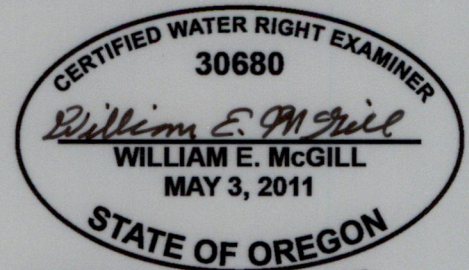

EXPIRES: 12-31-2024