


Additional POD Cert. 13593

Received by OWRD
JAN 24 2023
Salem, OR

CERTIFIED WATER RIGHT EXAMINER
72665
Gabriel M. Williams
GABRIEL M. WILLIAMS
JULY 10, 2018
STATE OF OREGON
RENEWS: 6/30/24

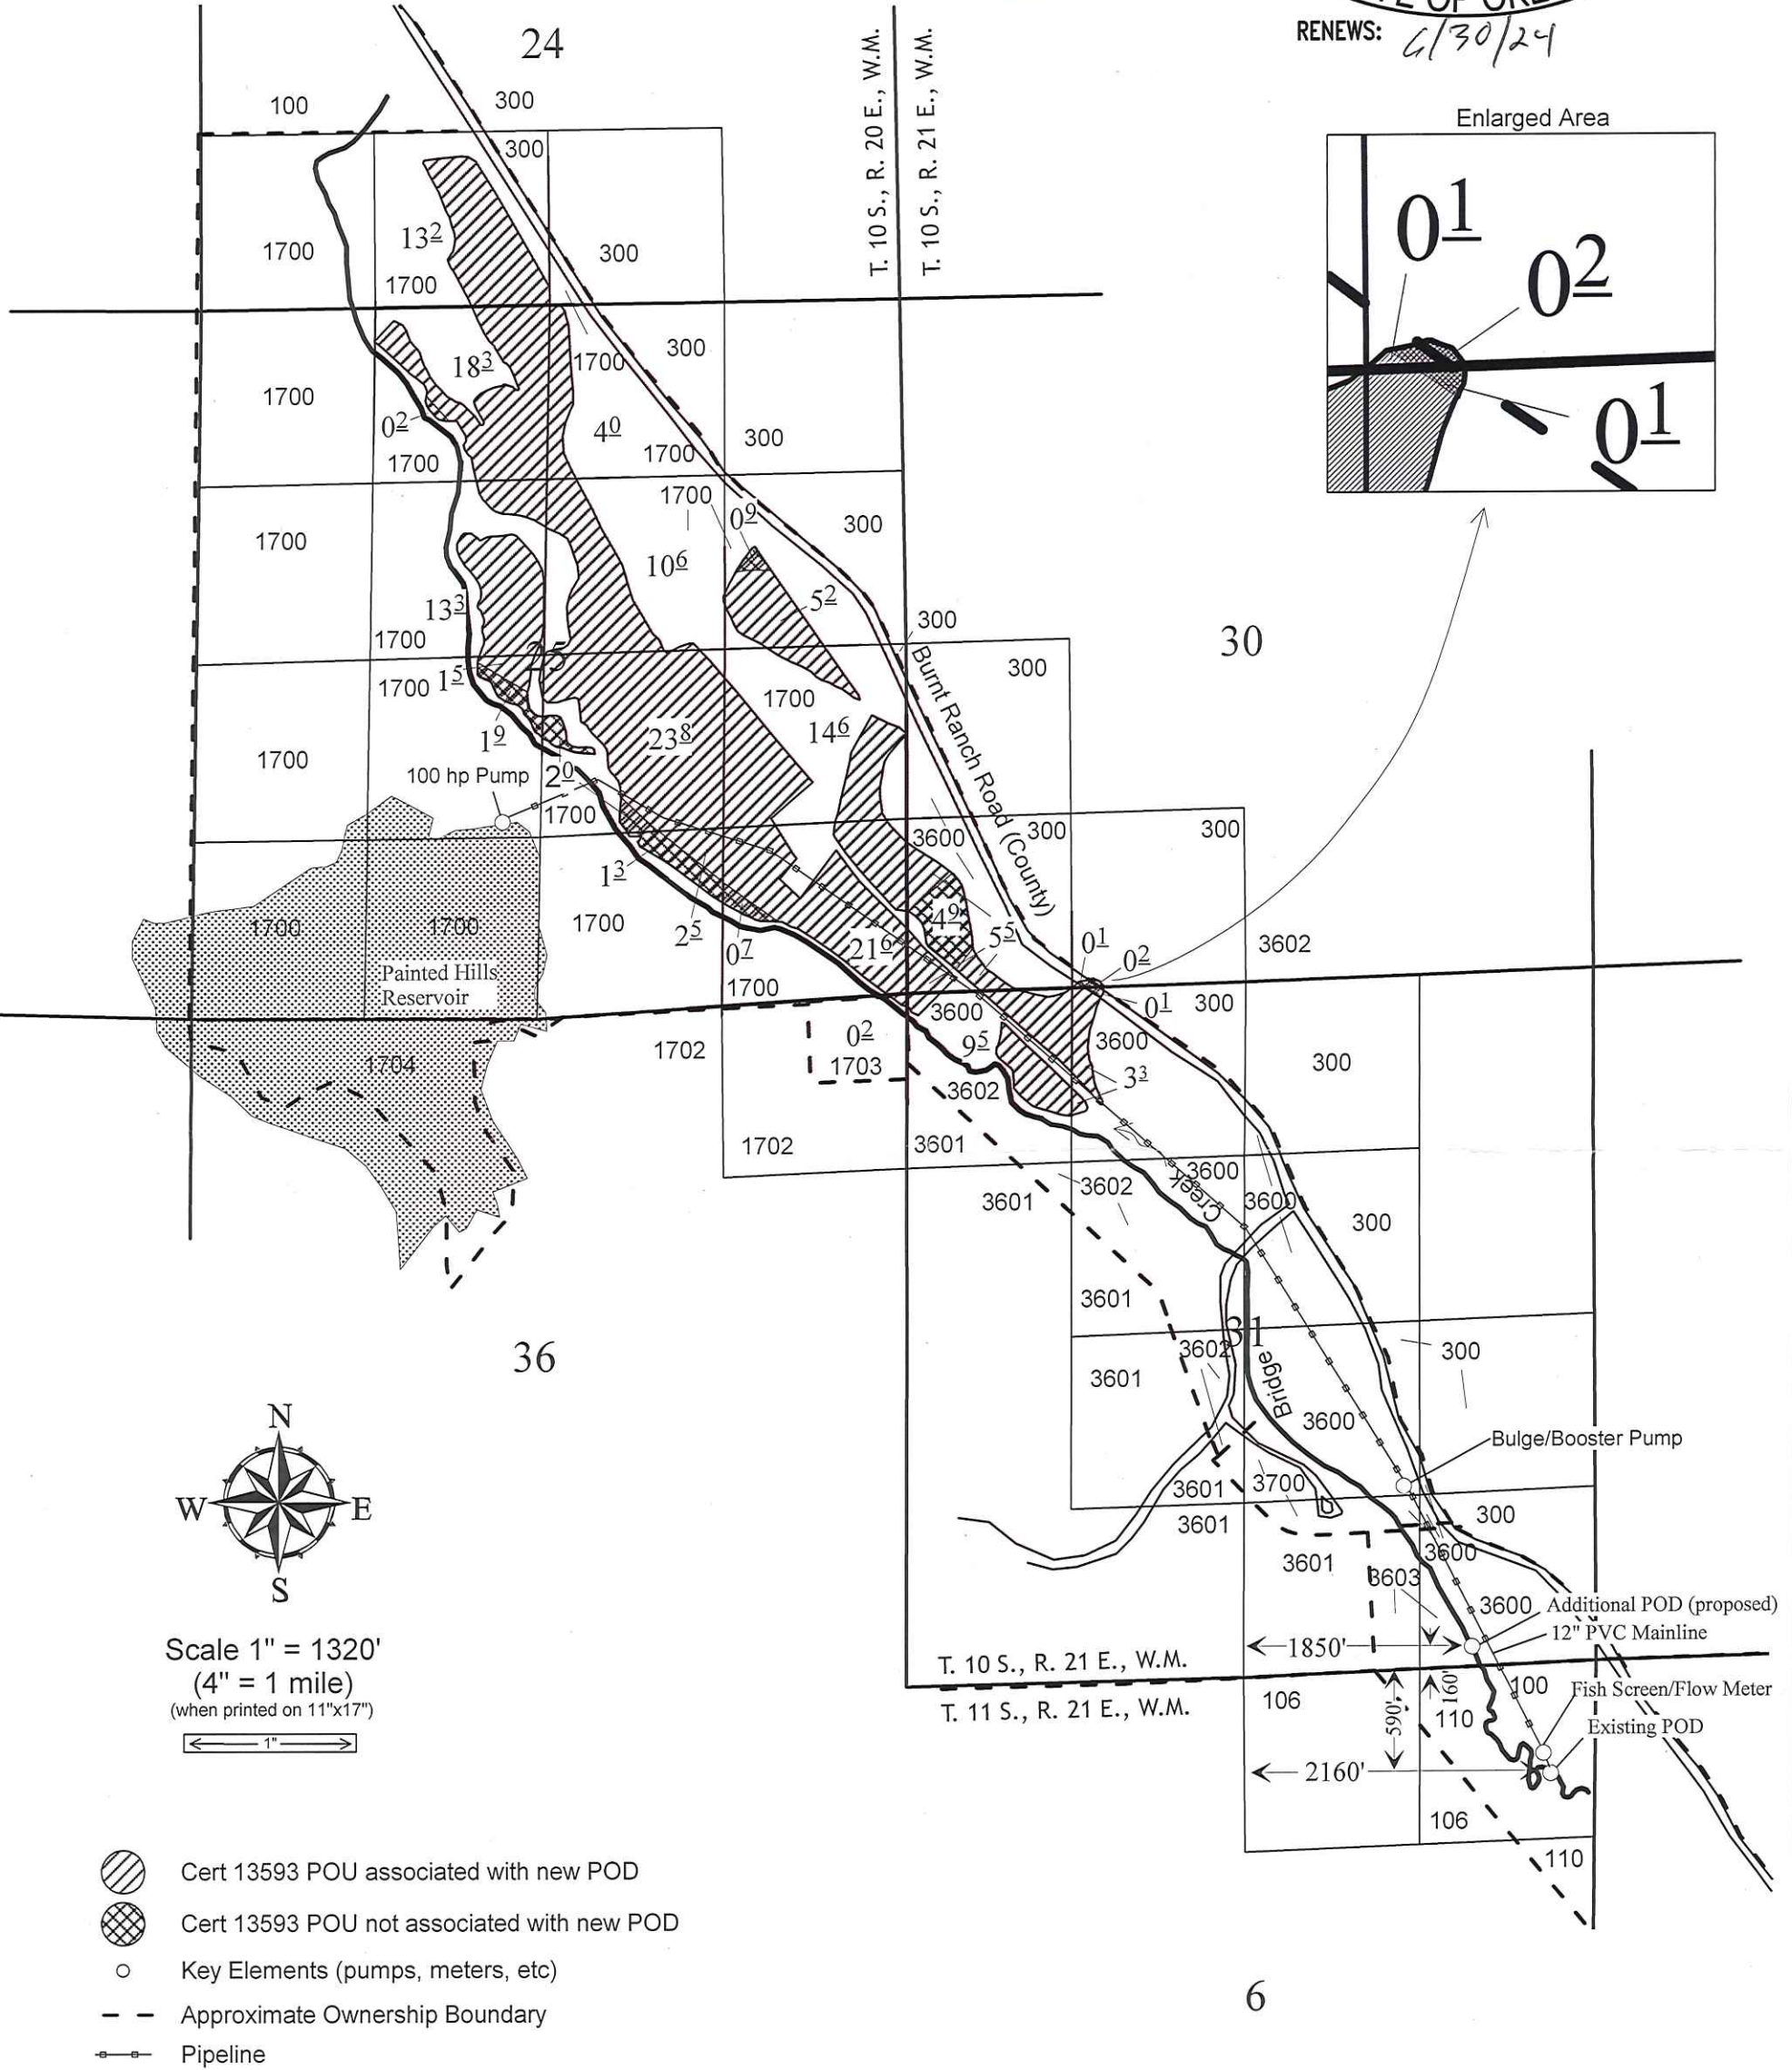

This map is for the purpose of locating a water right only and is not intended to provide legal dimensions or locations of property ownership lines.

Federal Land Ownership Taxlots: 100, 106, 110, 300, 1702, 3601, 3602, 3603, 3700

BCR - 1.1	DRAWING:	DRAWN BY: GMM	SHEET TITLE: POD Map	PROJECT: 13593 Additional POD	PROJECT LOCATION: MITCHELL, OREGON	CLIENT: Bridge Creek Ranch, LLC	RSI Resource Specialists INC. 1180 SW LAKE RD, STE 202 REDMOND, OR 97756 (541) 771-6911 gabe@RSIengr.com	DRAWING STATUS	DATE	No.	REVISION	DATE
								DRAFT	12/5/22			
								FINAL	1/16/23			