


Additional POD Cert. 96311

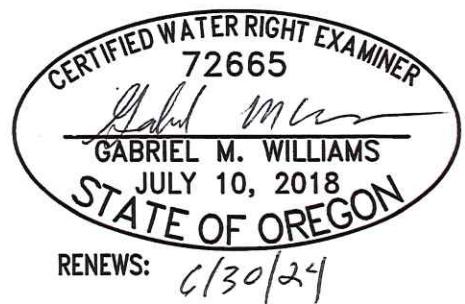

RENEWS: 6/30/24

S: 6/30/24


JULY 10, 2018

STATE OF OREGON

Received by OWRD

JAN 24 2023

Salem, OR


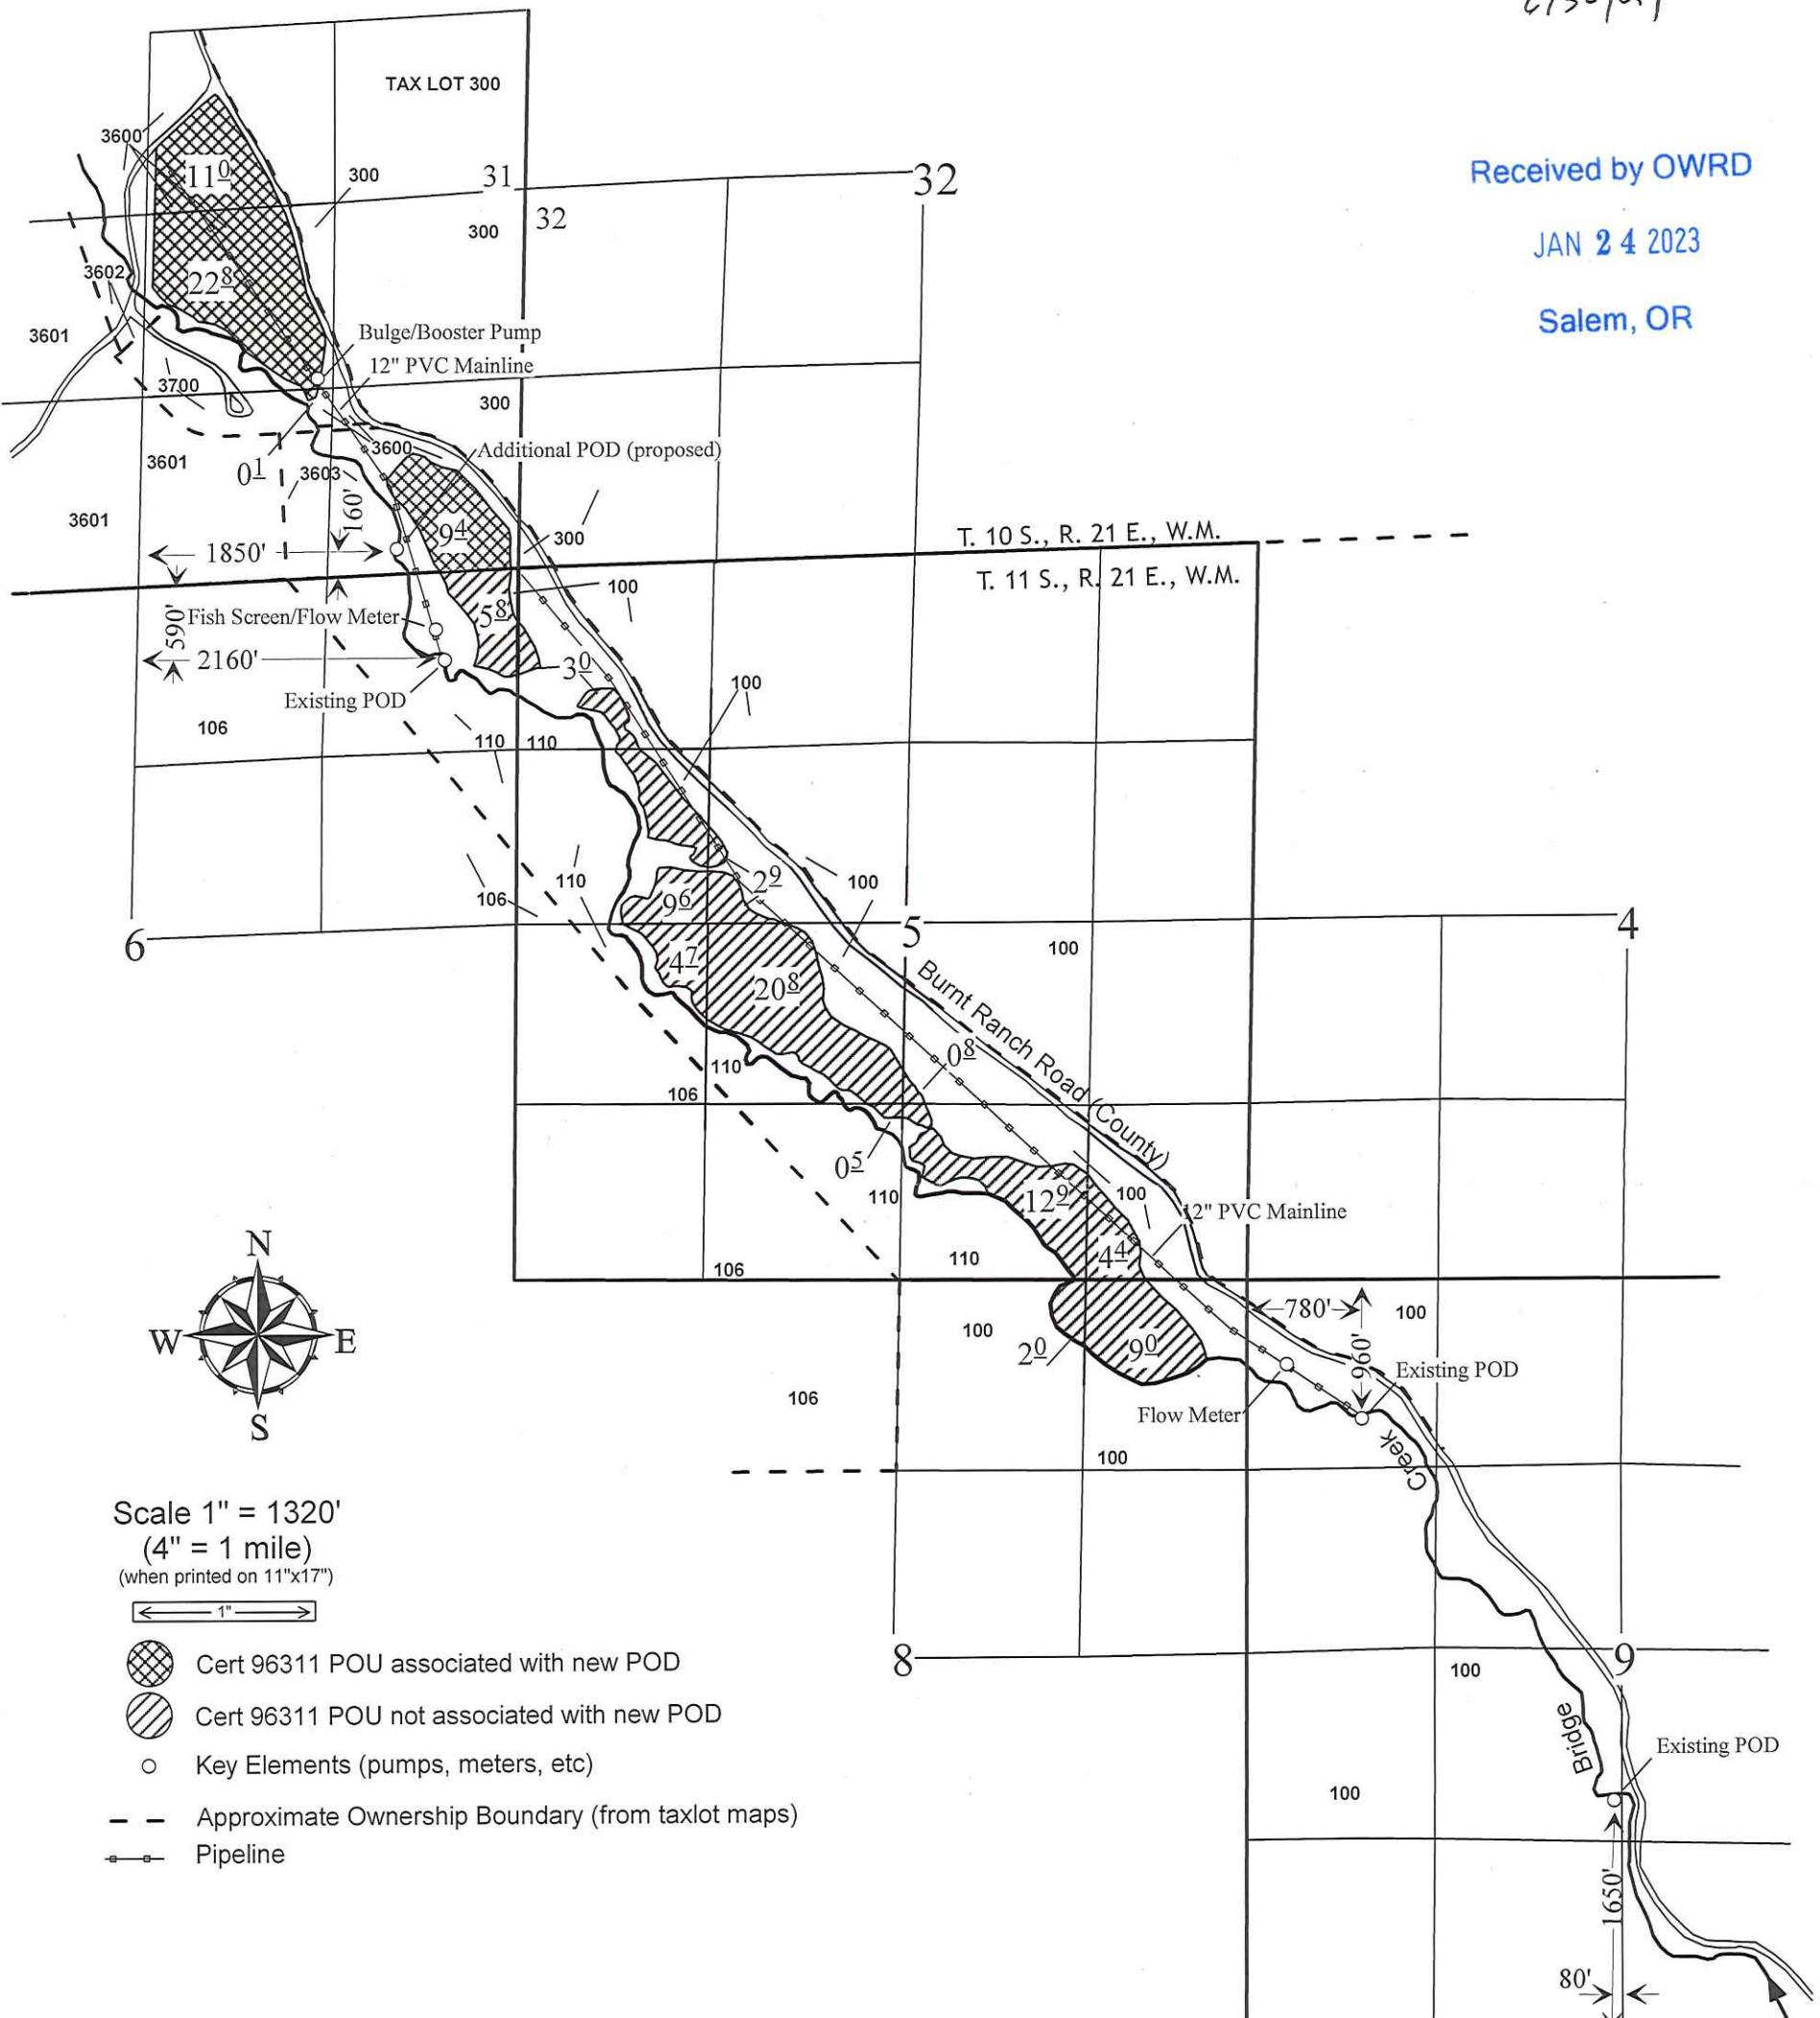


This map is for the purpose of locating a water right only and is not intended to provide legal dimensions or locations of property ownership lines.

Federal Land Ownership Taxlots:100,106,110,300,3601,3602,3603,3700

SHEET TITLE: 96311 Additinal POD		 Resource Specialists INC. 1180 SW LAKE RD, STE 202 REDMOND, OR 97756 (541) 771-6911 gabe@RSlengr.com				
SHEET NUMBER: S6 - 1.1	PROJECT NUMBER: 96311	DRAWING STATUS	DATE	No.	REVISION	DATE
POD Map		DRAFT	11/1/22			
DRAWN BY: GMW		FINAL	1/16/23			
DRAWING:						

Claim of Beneficial Use Map (T-9873)

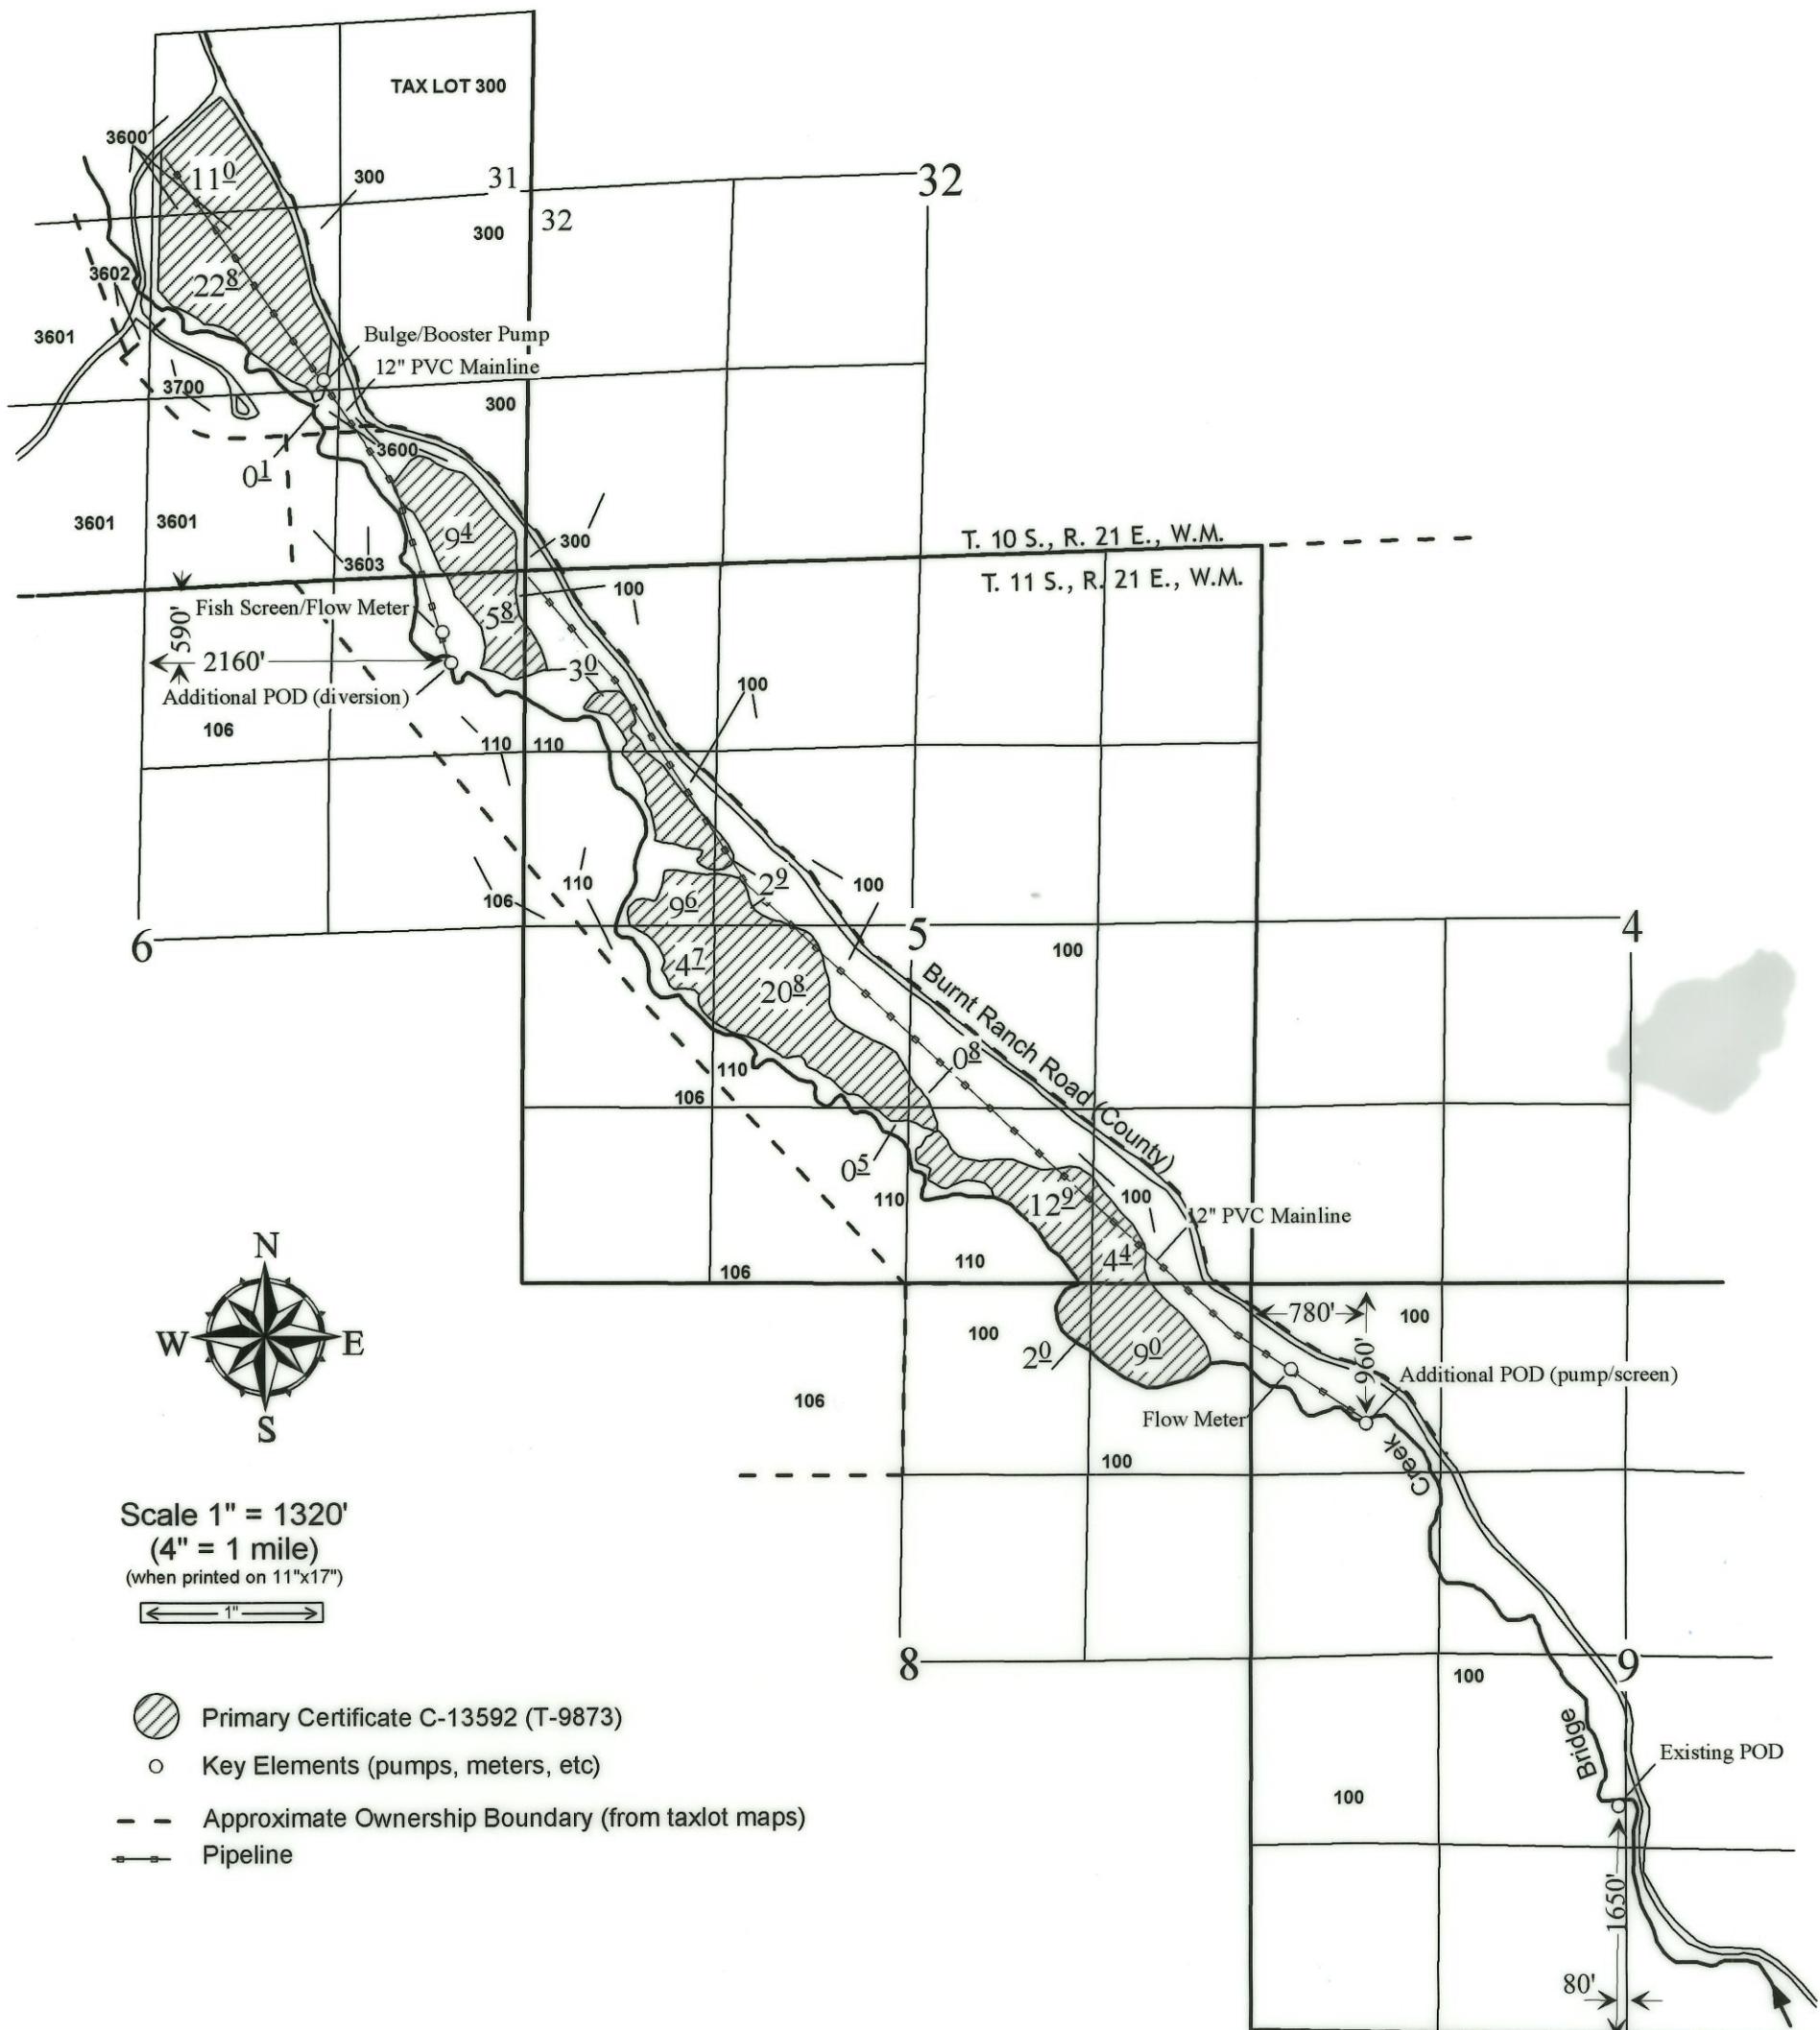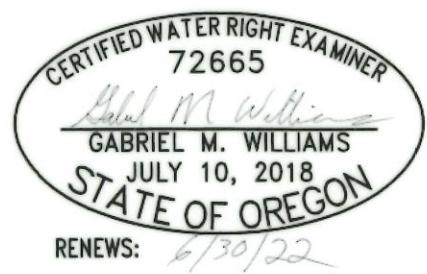

RECEIVED

APR 15 2022

OWRD

COBU MAP #2022