


Certificate 6411
Area inside red to
be cancelled.

T.4S., R.39E., W.M.

No map available
for C.6411

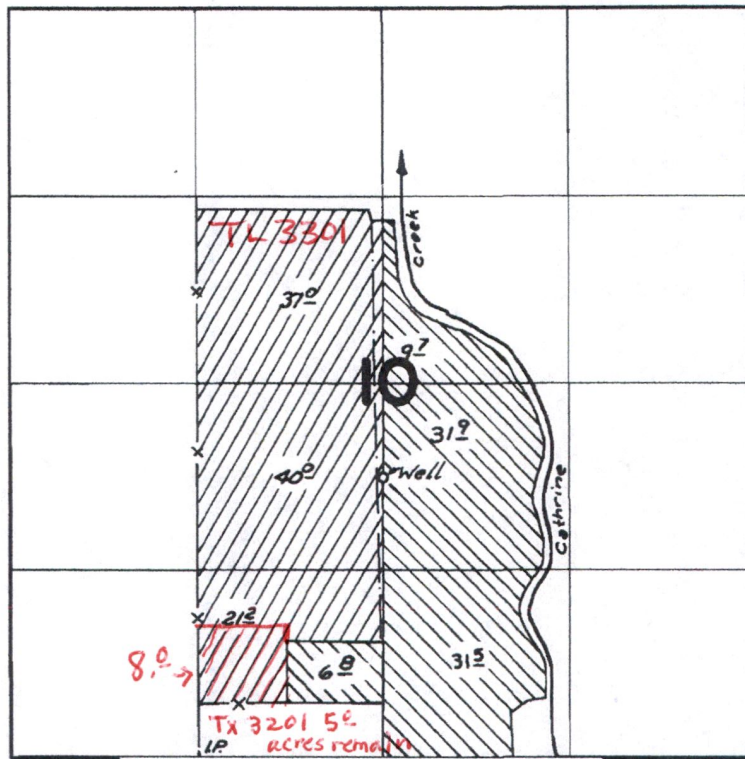

Well Loc.: 1980' N. from $5\frac{1}{4}$ Cor. Sec. 10

 Primary
 Suppl.

FINAL PROOF SURVEY UNDER

Application No. G-6314 Permit No. G-5804
IN NAME OF

David C. Baum

Surveyed Sept 24, 1976, by D. M. Norby

RECEIVED

MAR 27 2023

OWRD

PTS-1976-C *SB*