



CLAIM OF BENEFICIAL USE


NE 1/4 - NE 1/4 - SECTION 05
T. 23 S., R. 12 W., W.M.
COOS COUNTY, OREGON
PLAT OF BLACK CREEK PARK

RECEIVED

JAN 04 2021

OWRD


SCALE: 1" = 200'

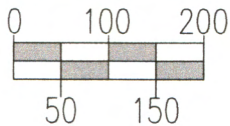

POD 1 - 360' SOUTH & 950' WEST
OF THE NORTHEAST CORNER OF
SECTION 5, T. 23 S. - R. 12 W.
W.M. COOS COUNTY, OREGON
LAT 43°36'37.02" LONG 124°08'41.36"

BLACK CREEK ARM
TENMILE LAKE

NE 1/4 - NE 1/4
SECTION 5

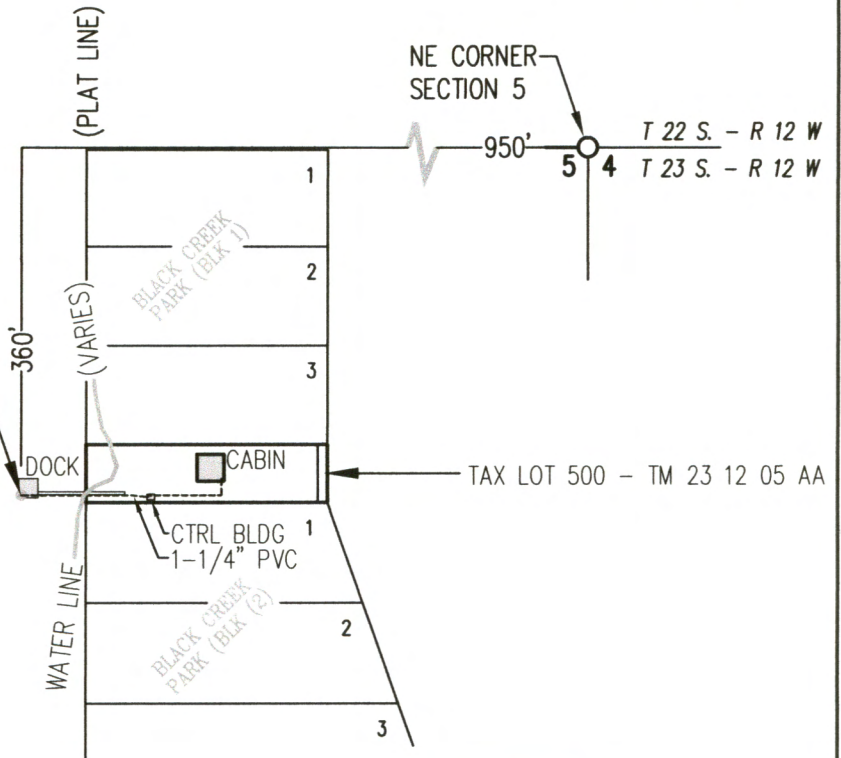

FOR:
TODD & SUSAN TRIPP
1458 NUTWOOD AVENUE
COOS BAY, OREGON 97420

PREPARED BY:
dodge surveying & planning
656 S. 12TH CT.
COOS BAY, OR. 97420

LEGEND:



FLOAT DOCK / HOUSE / CTRL BLDG



POINT OF DIVERSION

dodge surveying & planning
(541) 404-3709 | rdodge@tgei.com



SIX FIVE SIX S. 12TH CT.
COOS BAY, OREGON 97420

DATE: DECEMBER 30, 2020



NOTE: THIS MAP WAS PREPARED FOR
THE PURPOSE OF IDENTIFYING THE
LOCATION OF A WATER RIGHT ONLY
AND IS NOT INTENDED TO PROVIDE
LEGAL DIMENSIONS OR LOCATION OF
PROPERTY OWNERSHIP LINES.