

T8S R23E & T9S R22E, WM WHEELER COUNTY, OR



0 1,320 Feet

1" = 1,320'

● POD

■ Fish Screen

--- Creek

POU IR 1903 Priority

POU IR 1904 Priority

POU IR 11-5-1919 Priority


Township

Section

--- Quarter Quarter

Tax Lot

POD Location:
950' N, 100' E of the SW Cor Sec 31,
T8S R23E, WM

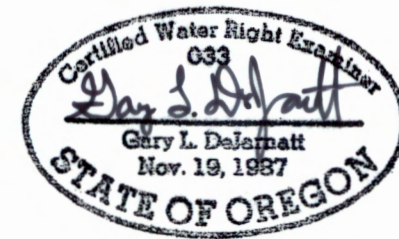

RENEWAL DATE 12/31/2021



CLAIM OF BENEFICIAL USE MAP SPAULDING RANCH


Date: 10/12/2020

T-9336

Project # 20063

This map is not intended
to provide legal dimensions
or locations of property
ownership lines.

WATER RIGHT SERVICES, LLC
PO BOX 1830, BEND, OR 97709
WWW.OREGONWATER.US CCB # 197121
johnshort@usa.com 541-389-2837

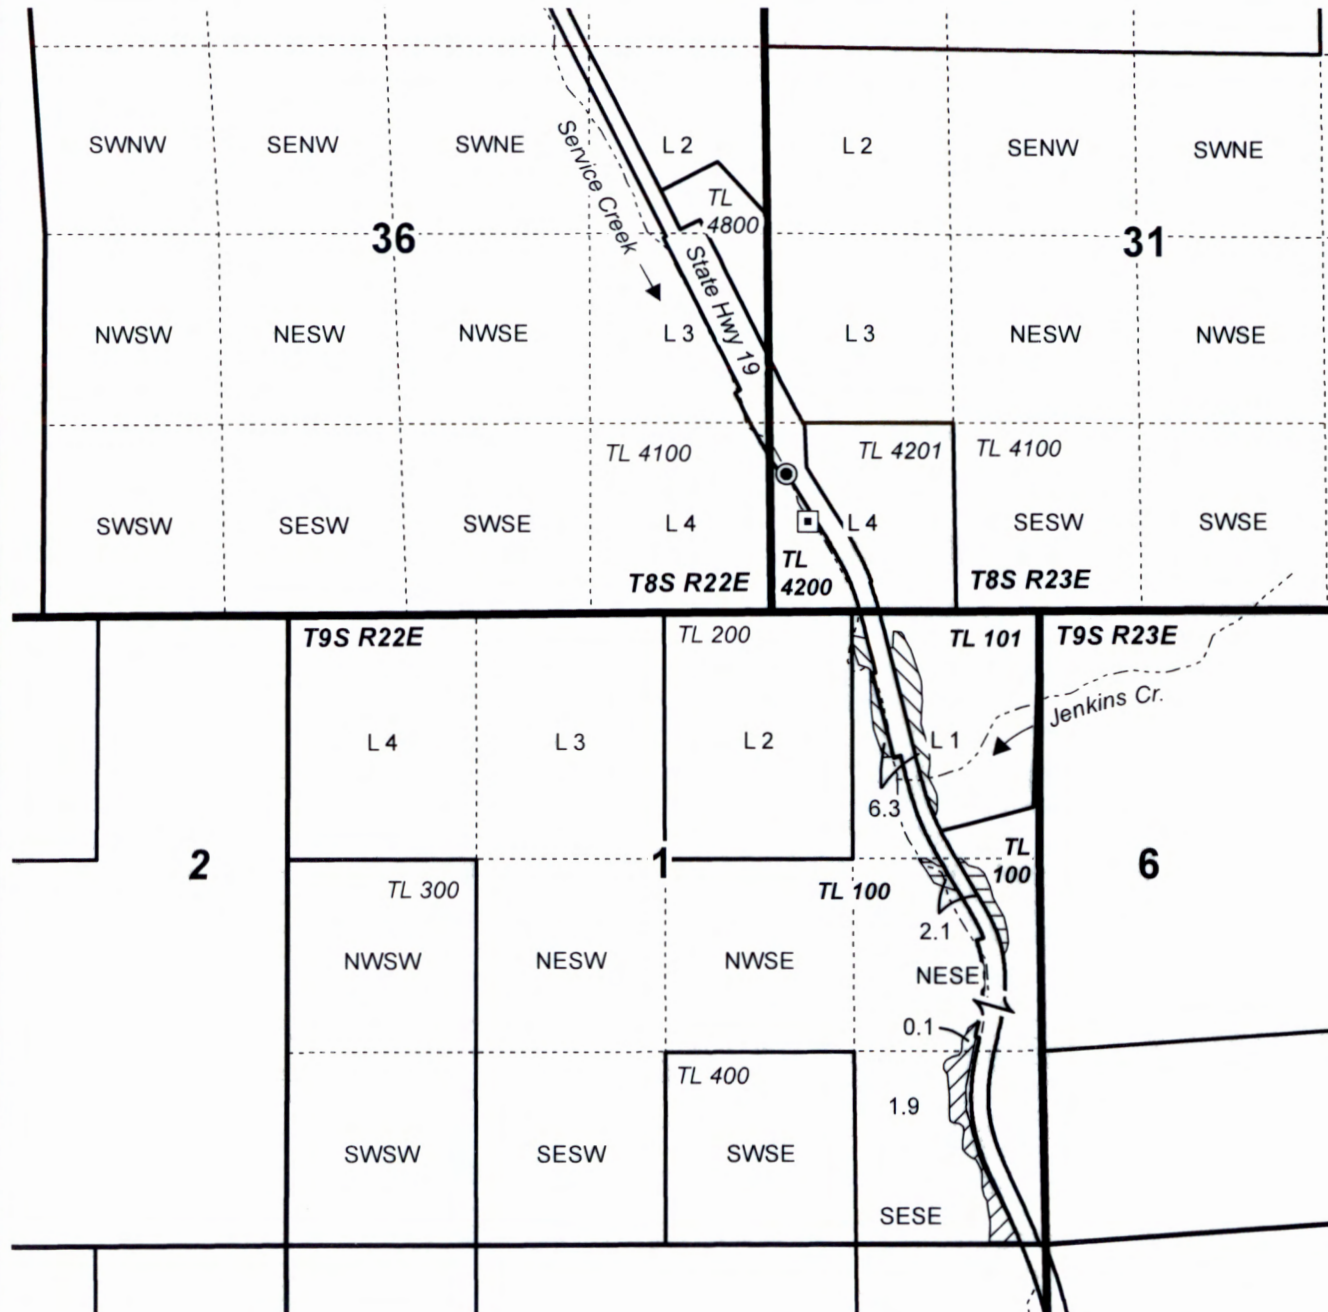

RECEIVED
JAN 15 2021
OWRD