



T8S R23E & T9S R22E, WM WHEELER COUNTY, OR

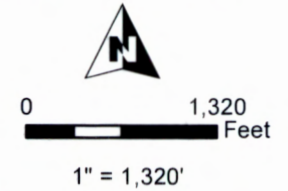


- POD
- Fish Screen
- Creek
- POU IR 1903 Priority
- POU IR 1904 Priority
- POU IR 11-5-1919 Priority
- Township
- Section
- Quarter Quarter
- Tax Lot

POD Location:
950' N, 100' E of the SW Cor Sec 31,
T8S R23E, WM

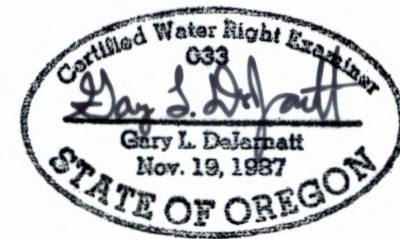

RENEWAL DATE 12/31/2021

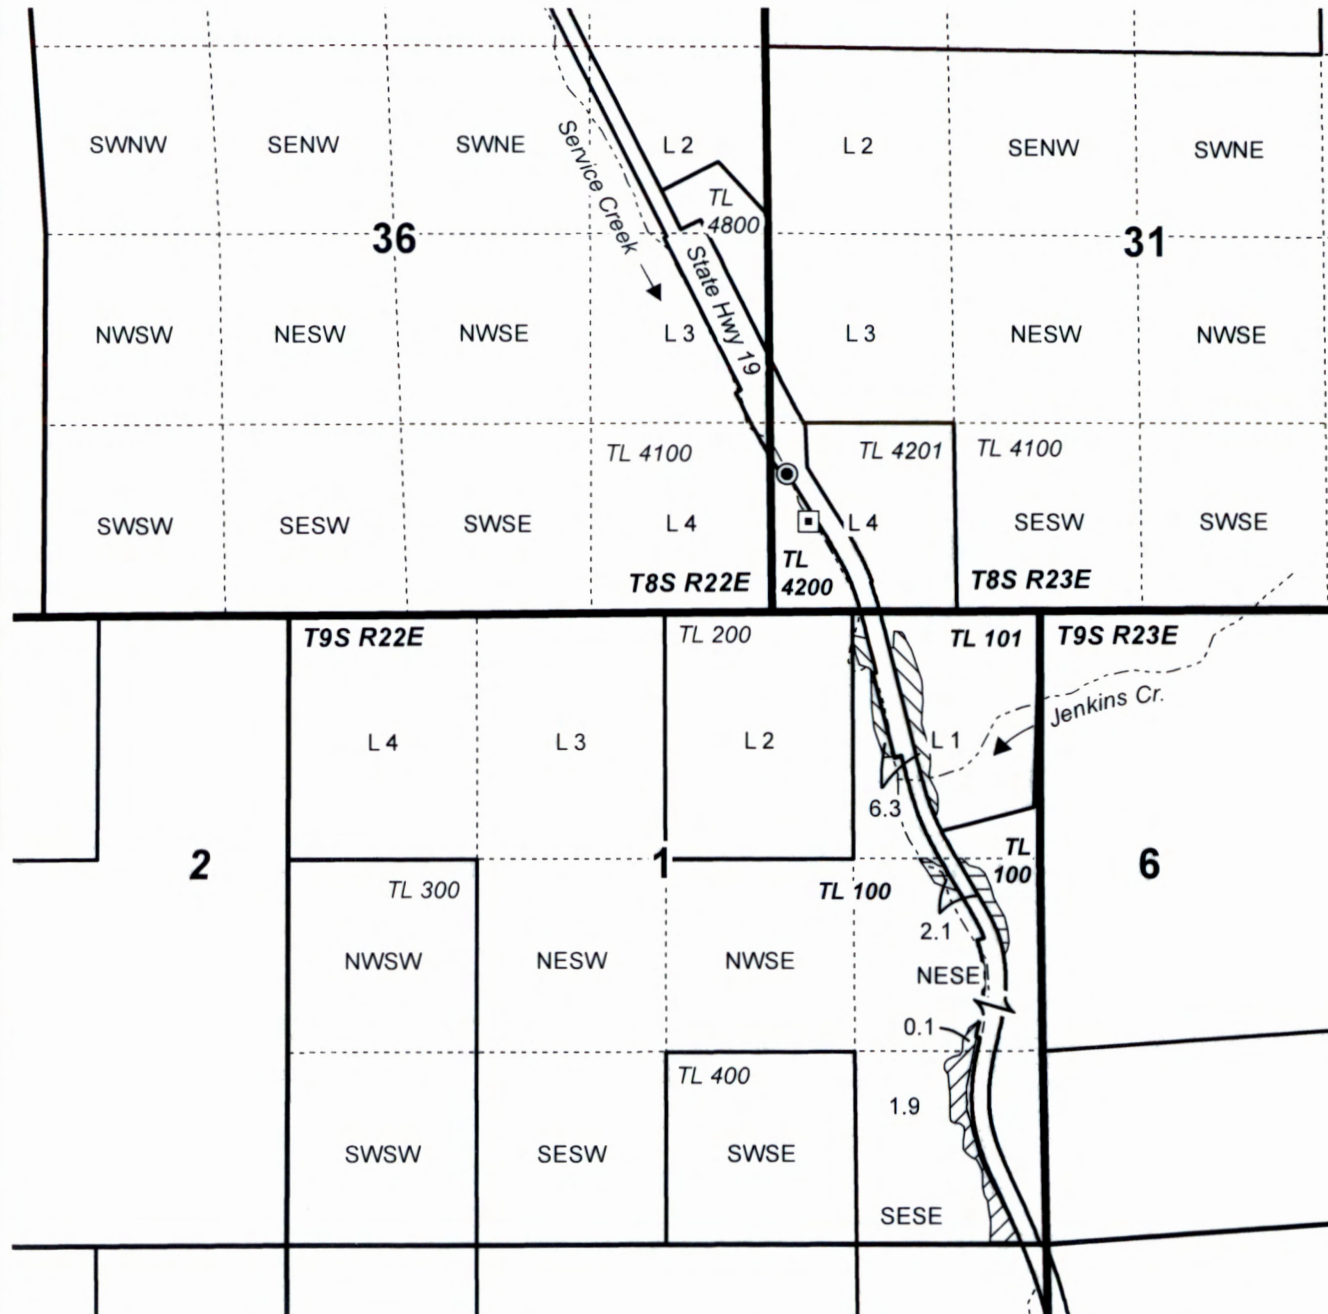

CLAIM OF BENEFICIAL USE MAP SPAULDING RANCH

Date: 10/12/2020

T-9336

Project # 20063

This map is not intended
to provide legal dimensions
or locations of property
ownership lines.

WATER RIGHT SERVICES, LLC
PO BOX 1830, BEND, OR 97709
WWW.OREGONWATER.US CCB # 197121
johnshort@usa.com 541-389-2837

RECEIVED

JAN 15 2021

OWPRD