


T.3S. R.1E. Section 8, W.M.

RECEIVED

07/2020

DWRD

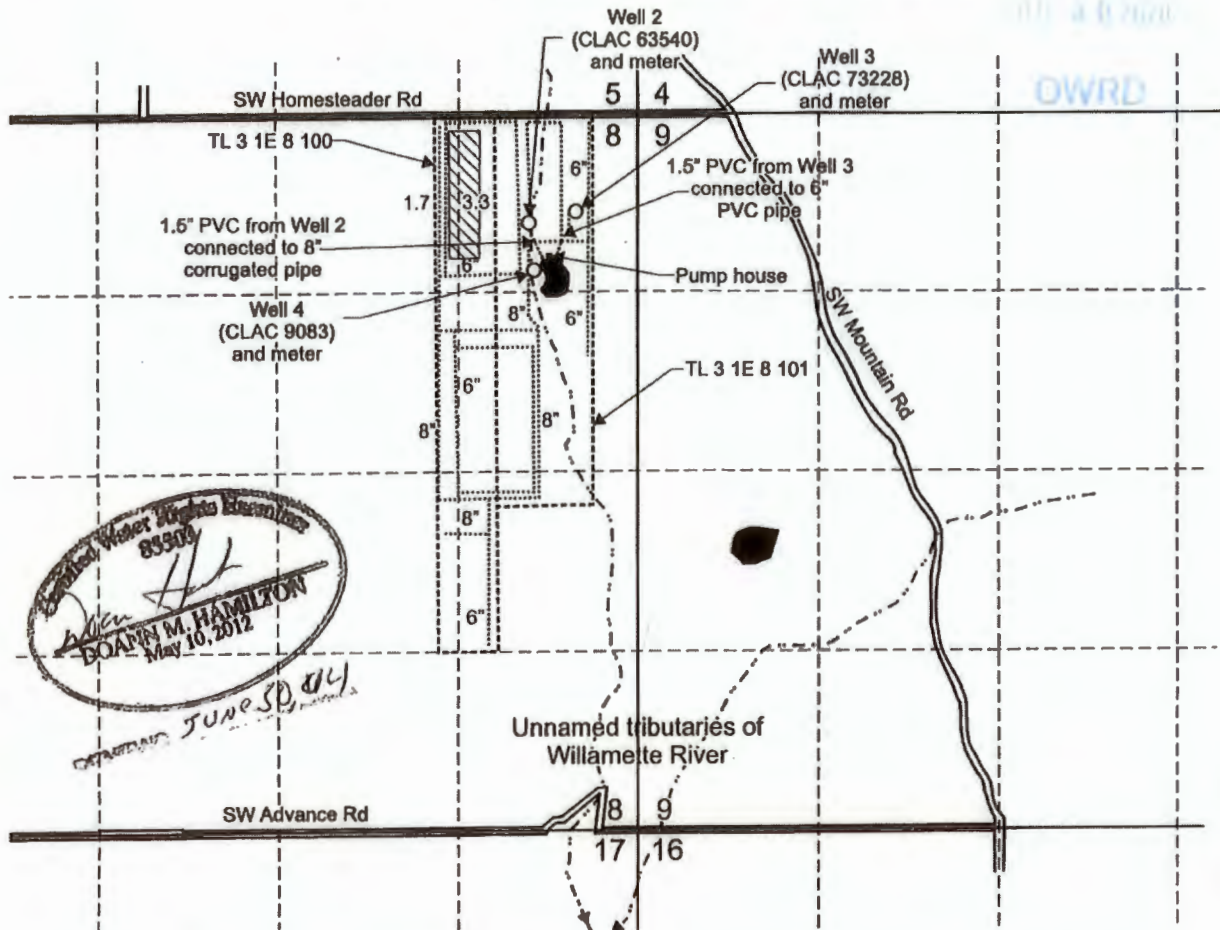

Well 2 (CLAC 63540) is located 809 feet south and 801 feet west from the NE corner, Section 8.
 Well 3 (CLAC 73228) is located 725 feet south and 455 feet west from the NE corner, Section 8.
 Well 4 (CLAC 9083) is located 1,160 feet south and 760 feet west from the NE corner, Section 8.

 Area (5.0 Acres) irrigated under T-13045 (formerly under Certificate 82444), priority date August 17, 1971.

----- Tax lot boundary

..... Water main line

Scale: 1" = 1,320'



This map was prepared for the purpose of identifying the location of a water right only and is not intended to provide legal dimensions or location of property ownership lines.



Claim of Beneficial Use Map
T-13045 (formerly Certificate 82444)

Pacific Hydro-Geology Inc.

KAW Investments
 T.3S. R.1E. Section 8, W.M.

07/2020