

CLAIM OF BENEFICIAL USE MAP

FOR PERMIT APPLICATION G-17139


MIKE PEILA

TOWNSHIP 24 SOUTH, RANGE 30 EAST, SECTION 36, W.M.
TAX LOT: 2200

APCE 171

AUG 18 2021

OWR

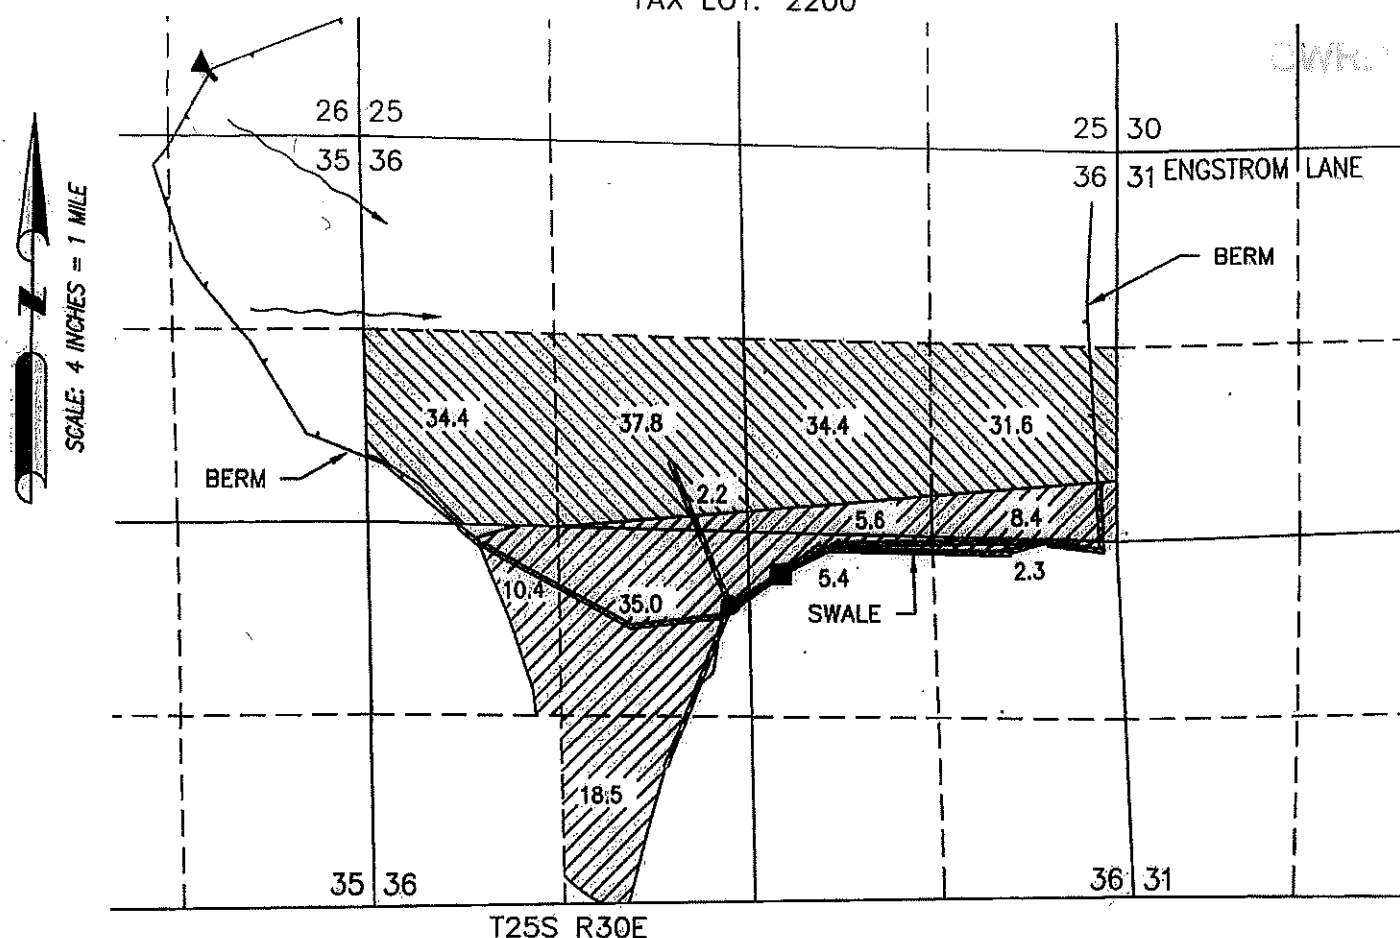

WELL 2 (HARN 844)

- LOCATED IN THE SE 1/4 SE 1/4 SECTION 26, T24S R30E, W.M. AND 220 FEET NORTH AND 4315 FEET EAST FROM THE SW CORNER OF SAID SECTION. FLOW METER IS LOCATED 11' SE FROM WELL.

WELL 3 (HARN 51332)

- LOCATED IN THE NE 1/4 SW 1/4 SECTION 36, T24S R30E, W.M. AND 1835 FEET NORTH AND 2625 FEET EAST FROM THE SW CORNER OF SAID SECTION. FLOW METER IS LOCATED 5' NW FROM WELL.

WELL 7 (HARN 52896)

- LOCATED IN THE NE 1/4 SW 1/4 SECTION 36, T24S R30E, W.M. AND 1845 FEET NORTH AND 2785 FEET EAST FROM THE SW CORNER OF SAID SECTION. FLOW METER IS LOCATED 6' E FROM WELL.



87.8 ACRES IR WATER RIGHTS FROM PERMIT G-18347, AS SHOWN.



138.2 ACRES IS WATER RIGHTS FROM PERMIT G-18347, AS SHOWN.



THIS MAP IS FOR THE PURPOSE OF LOCATING A WATER RIGHT ONLY AND HAS NO INTENT TO PROVIDE LEGAL DIMENSIONS OR THE LOCATION OF PROPERTY LINES

RENEWAL DATE: 12/31/2022

PREPARED FOR:

MIKE PEILA
P.O. BOX 537
HINES, OR 97738

PREPARED BY:



ALL POINTS ENGINEERING AND SURVEYING, INC.
P.O. BOX 767
(541) 548-5833
TERREBONNE, OR 97760
www.APEandS.com