



Transfer T-8469, Hildebrandt Claim of Beneficial Use

Township 5S, Range 3W, W.M.

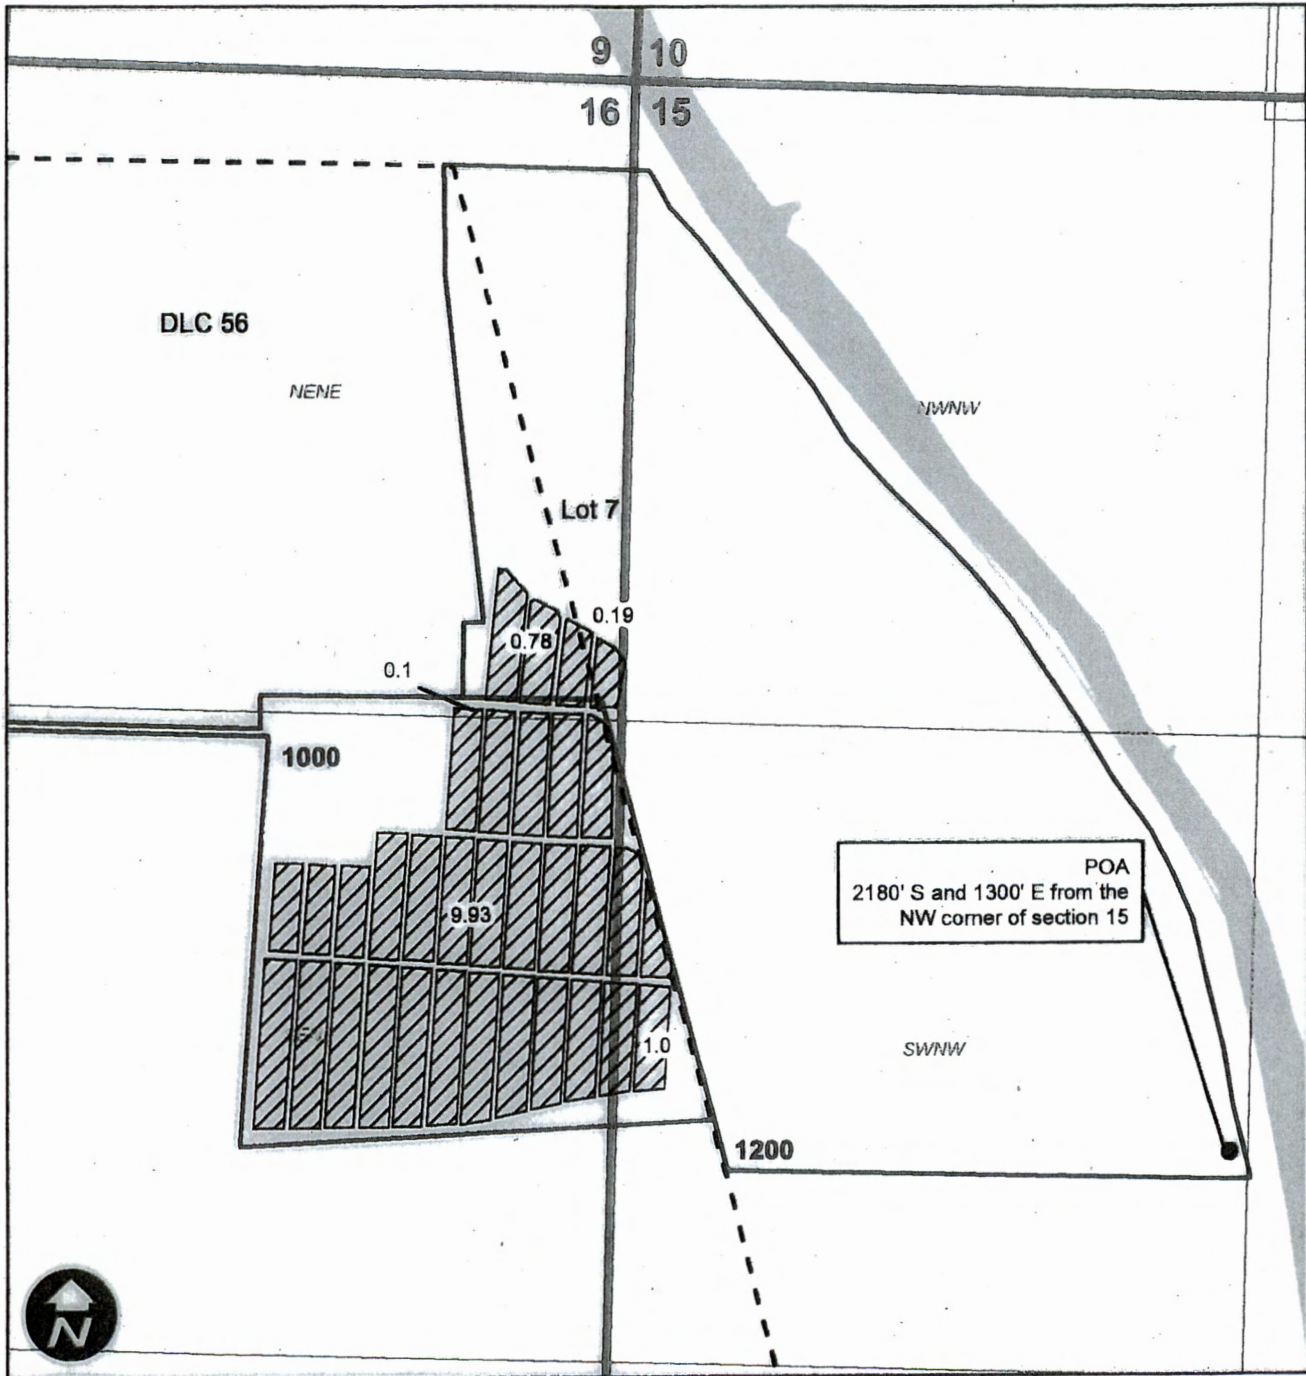

This map is not intended to provide legal dimensions or locations of property ownership lines.

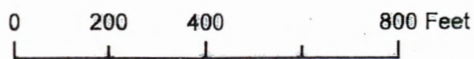

Legend

- Developed POU
- DLC
- Tax Lot

